
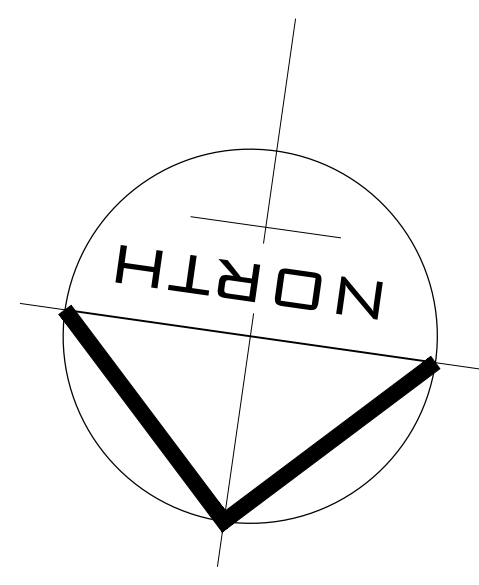


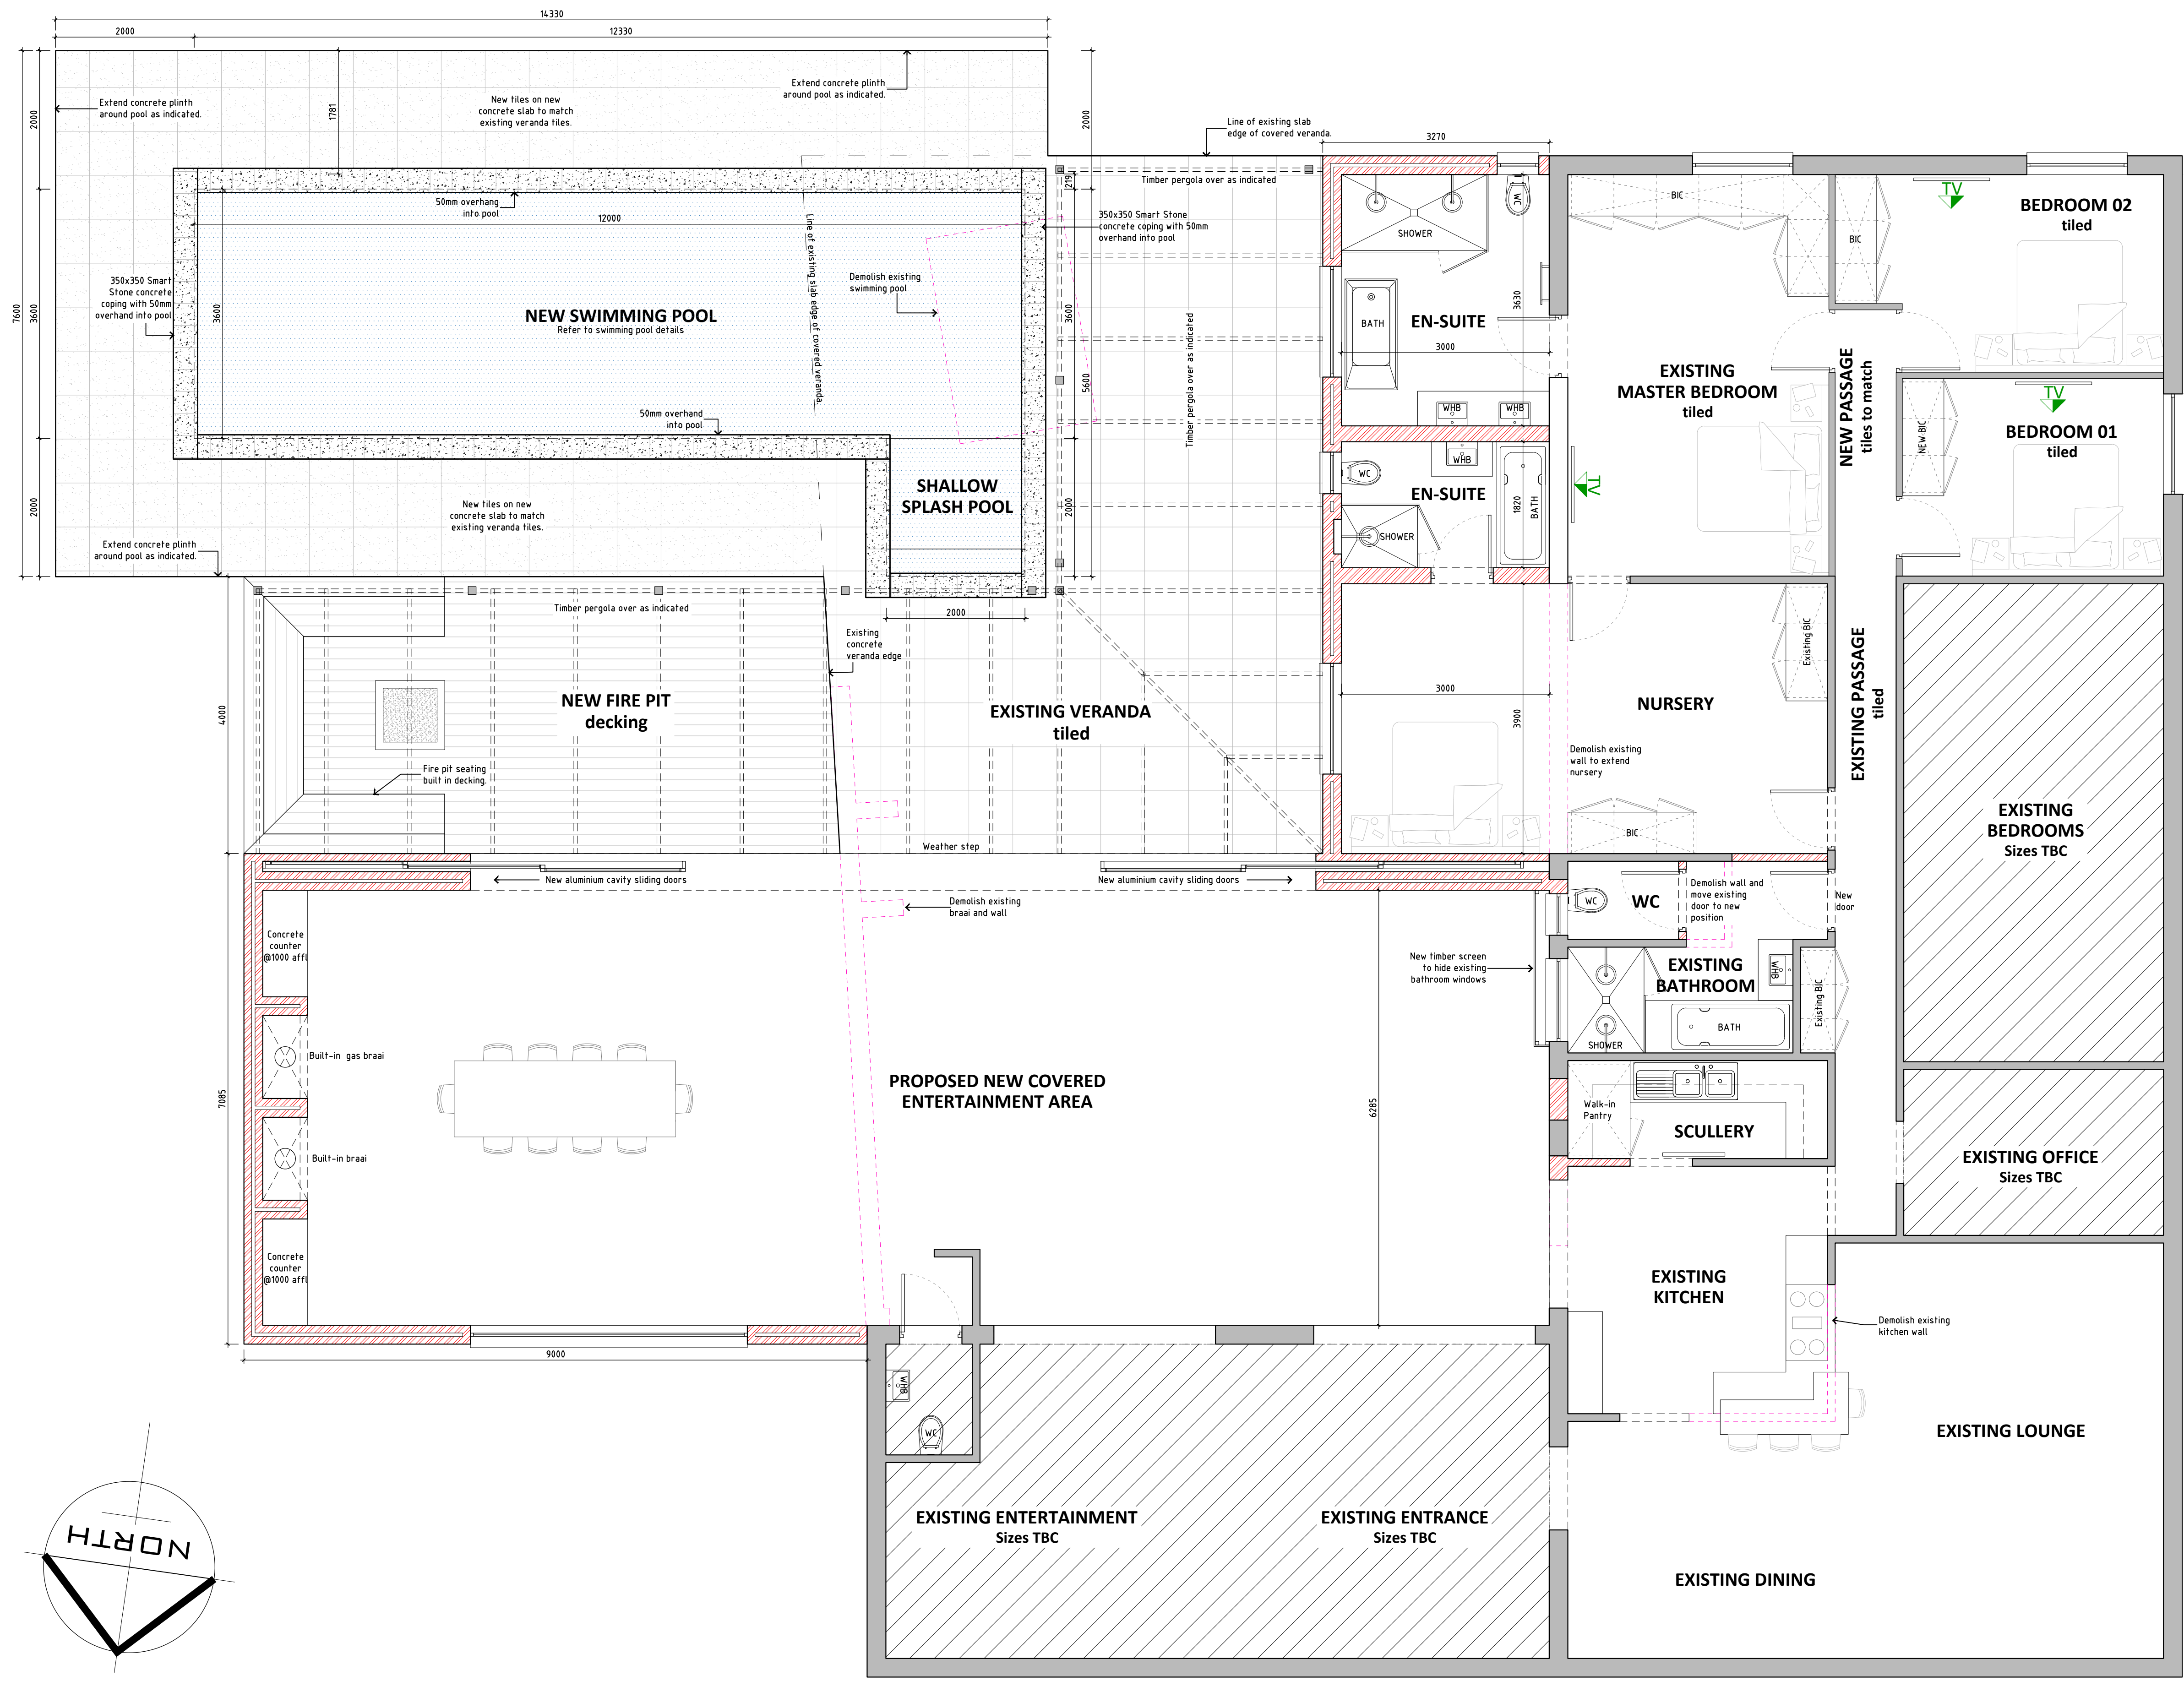

PART GROUND STOREY PLAN
SCALE 1:50

NOTES		
ALL DIMENSIONS AND LEVELS ARE TO BE VERIFIED ON SITE BY THE CONTRACTOR BEFORE COMMENCING ANY WORK. DIMENSIONS ARE NOT TO BE SCALED. ALL VARIATIONS AND DISCREPANCIES ARE TO BE BROUGHT TO THE ATTENTION OF THE DESIGNER BEFORE COMMENCING ANY WORK. COPYRIGHT OF THIS DRAWING,INCLUDING THE DESIGN AND DETAILS SHOWN HEREON IS RESERVED BY THE DESIGNER.		
REVISIONS		
REV.	DESCRIPTION	DATE
-	-	-/-/-
-	-	-/-/-
ISSUED FOR:		DATE
☐ PRELIMINARY		
☐ APPROVAL		
☐ TENDER		
☒ CONSTRUCTION		
AREA'S		
ERF		
South African Council for the Architectural Profession Registration No.1353		
EA ELLIS architecture		
Cell: 084 504 2438 Email: bob@ellisarch.co.za 13 Irvine Street Richmond Hill Port Elizabeth 6001		
PROJECT:		
AS BUILT GROUND STOREY & NEW SWIMMING POOL		
MR. & MRS. VENTER, 8 ORANJESINGEL, KIRKWOOD		
DRAWING:		
AS BUILT GROUND STOREY FLOOR PLAN SWIMMING POOL PLAN SWIMMING POOL SECTIONS		
PROJECT NO: V2020	SCALE: as shown	
DRAWN BY: KL	CHECKED:	
DATE: 20/01/2020	REVISION: A	
DRAWING NO: V2020.01		