


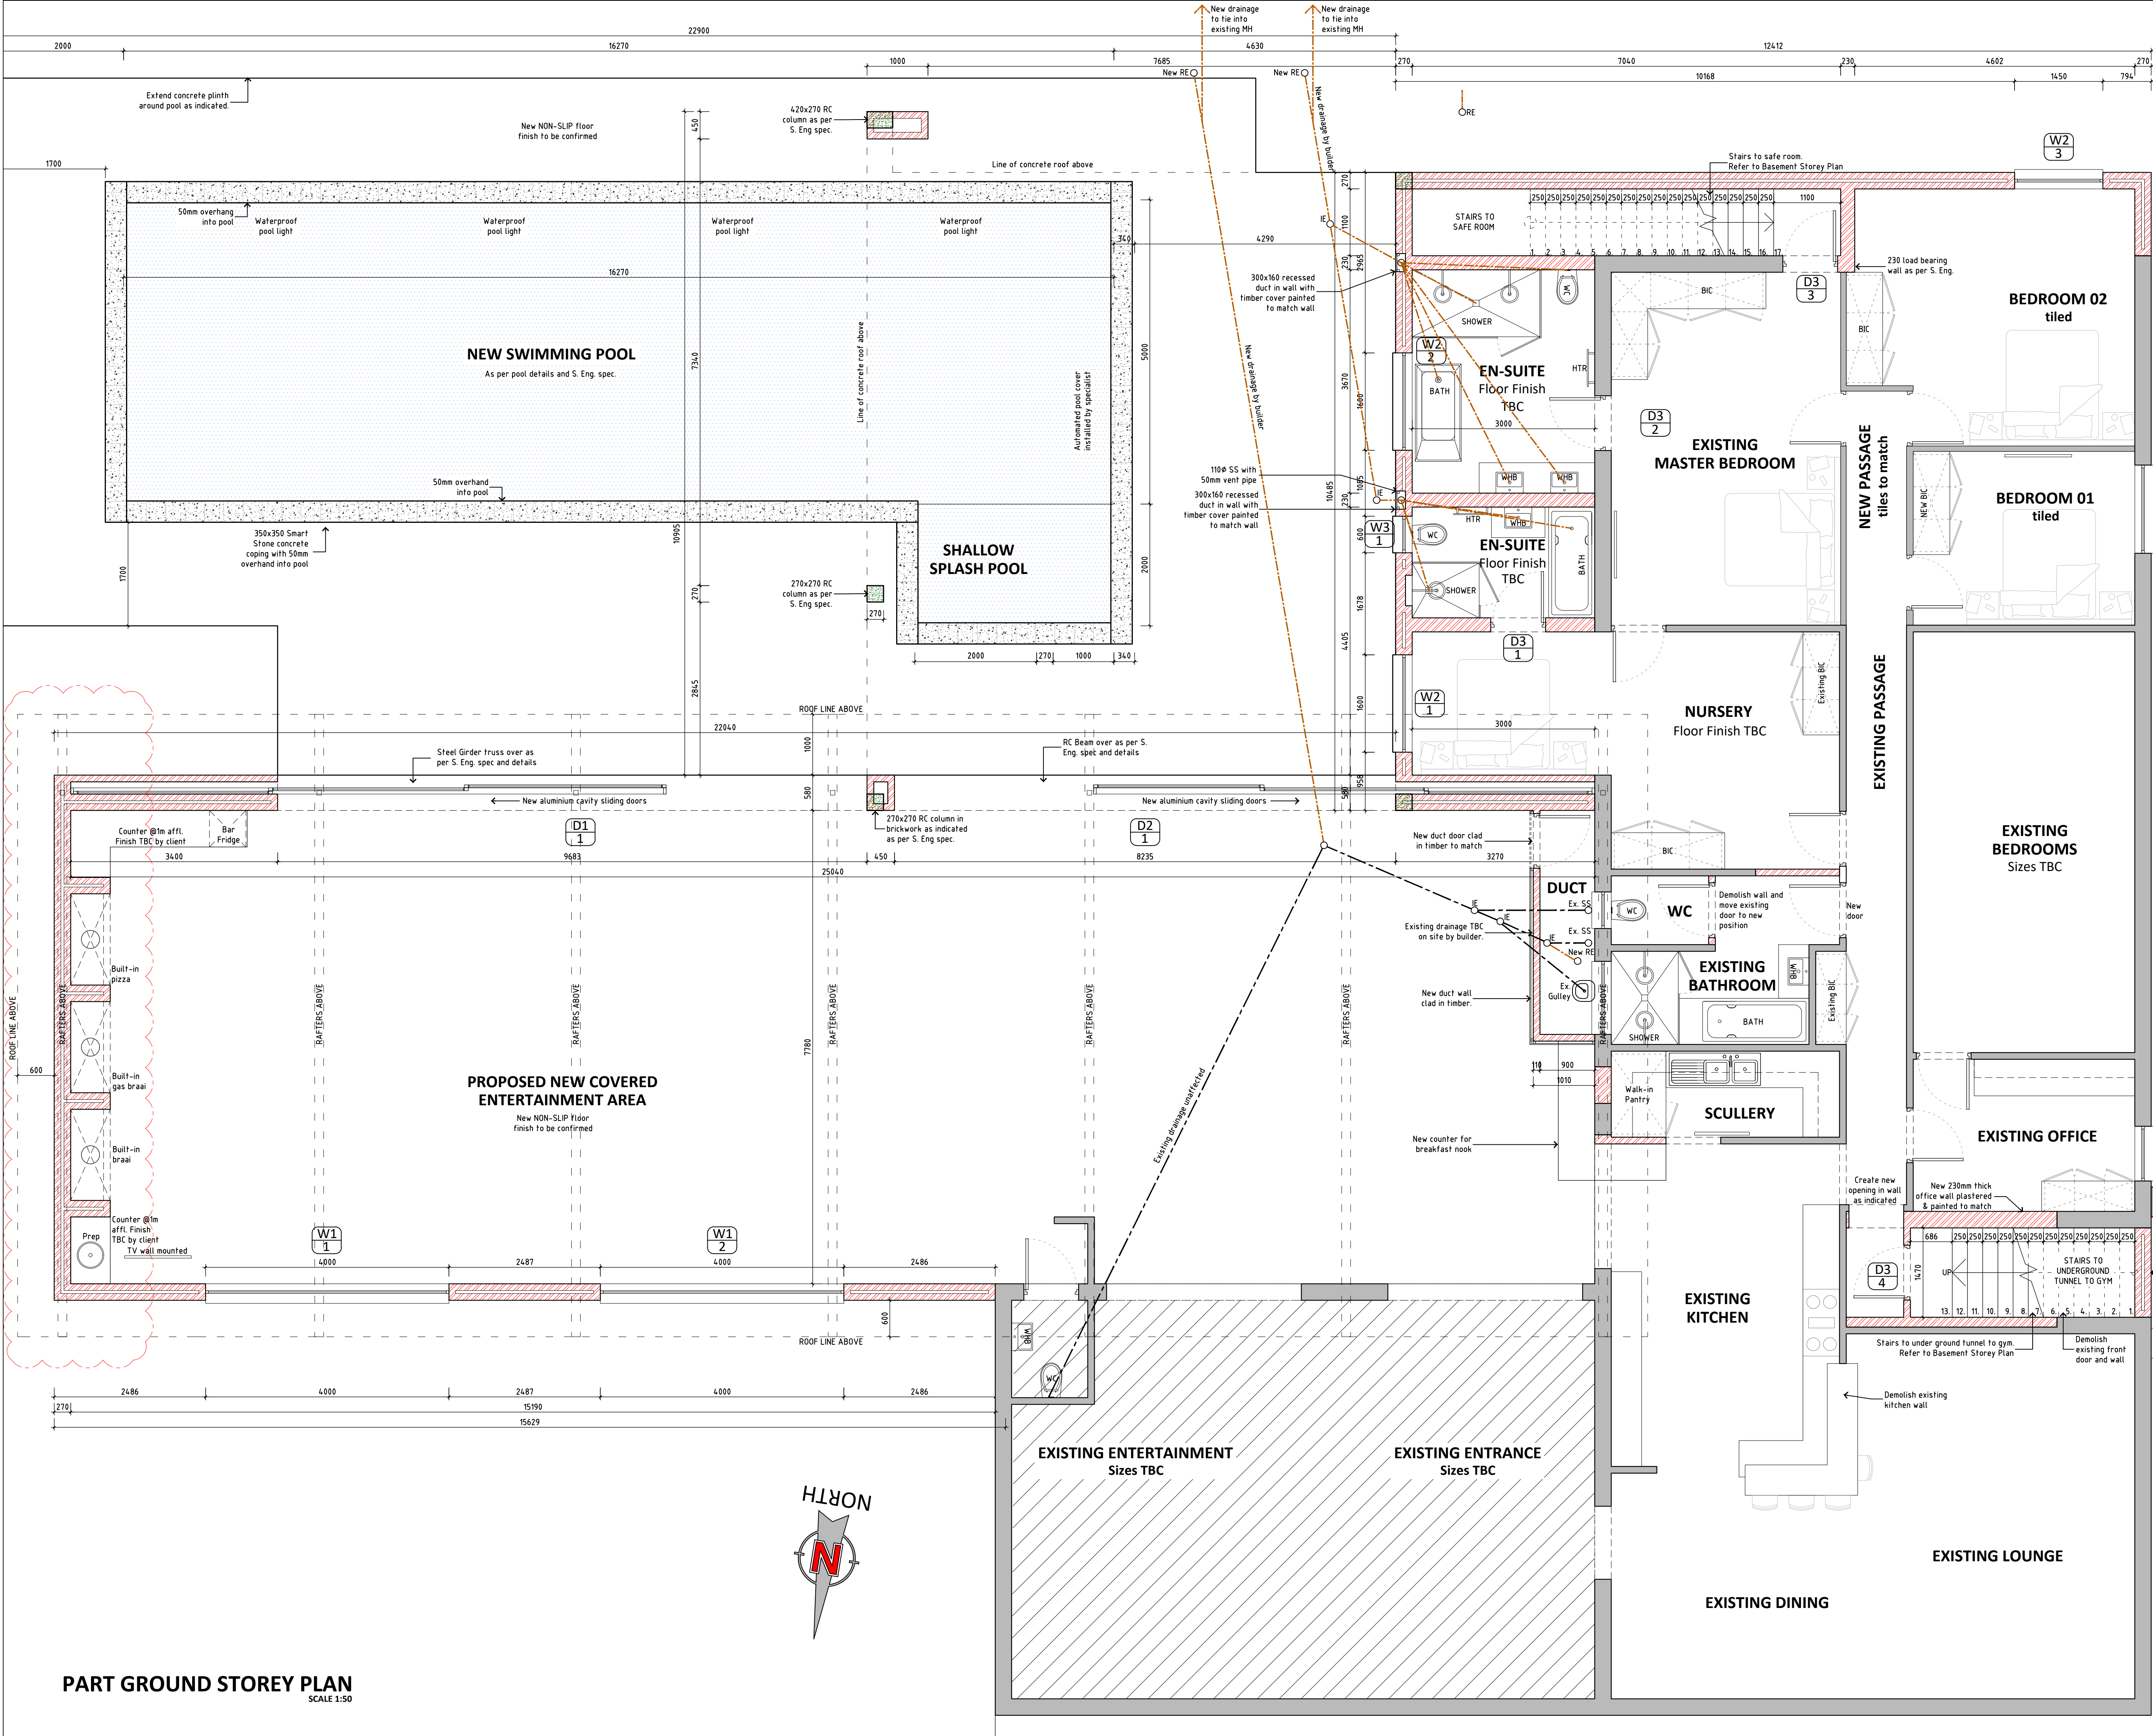

NOTES		
ALL DIMENSIONS AND LEVELS ARE TO BE VERIFIED ON SITE BY THE CONTRACTOR BEFORE COMMENCING ANY WORK. DIMENSIONS ARE NOT TO BE SCALED. ALL VARIATIONS AND DISCREPANCIES ARE TO BE BROUGHT TO THE ATTENTION OF THE DESIGNER BEFORE COMMENCING ANY WORK. COPYRIGHT OF THIS DRAWING, INCLUDING THE DESIGN AND DETAILS SHOWN HEREON IS RESERVED BY THE DESIGNER.		
REVISIONS		
REV.	DESCRIPTION	DATE
1	Revised as indicated	15/2/2021
2	Revised Entertainment area width	16/2/2021
3	Revised as indicated	26/2/2021
4	Revised as per new on site measurements	4/3/2021
5	Drainage added	15/3/2021
6	Outside steel rafters centered with walls, new duct & drainage	3/5/2021
-	-	-/-
-	-	-/-
ISSUED FOR:		DATE
☐ PRELIMINARY		
☐ APPROVAL		
☐ TENDER		
☒ CONSTRUCTION		
AREA's		
ERF		
South African Council for the Architectural Profession Registration No.1353		
Call: 084 504 2438 Email: bob@ellisarch.co.za 13 Irvine Street Richmond Hill Port Elizabeth 6001		
PROJECT:		
GROUND STOREY		
MR. & MRS. VENTER, 8 ORANJESINGEL, KIRKWOOD		
DRAWING:		
GROUND STOREY		
PROJECT NO: V2020	SCALE: as shown	
DRAWN BY: KL	CHECKED: BE	
DATE: 03/05/2021	REVISION: 6	
DRAWING NO: V2020.01		