




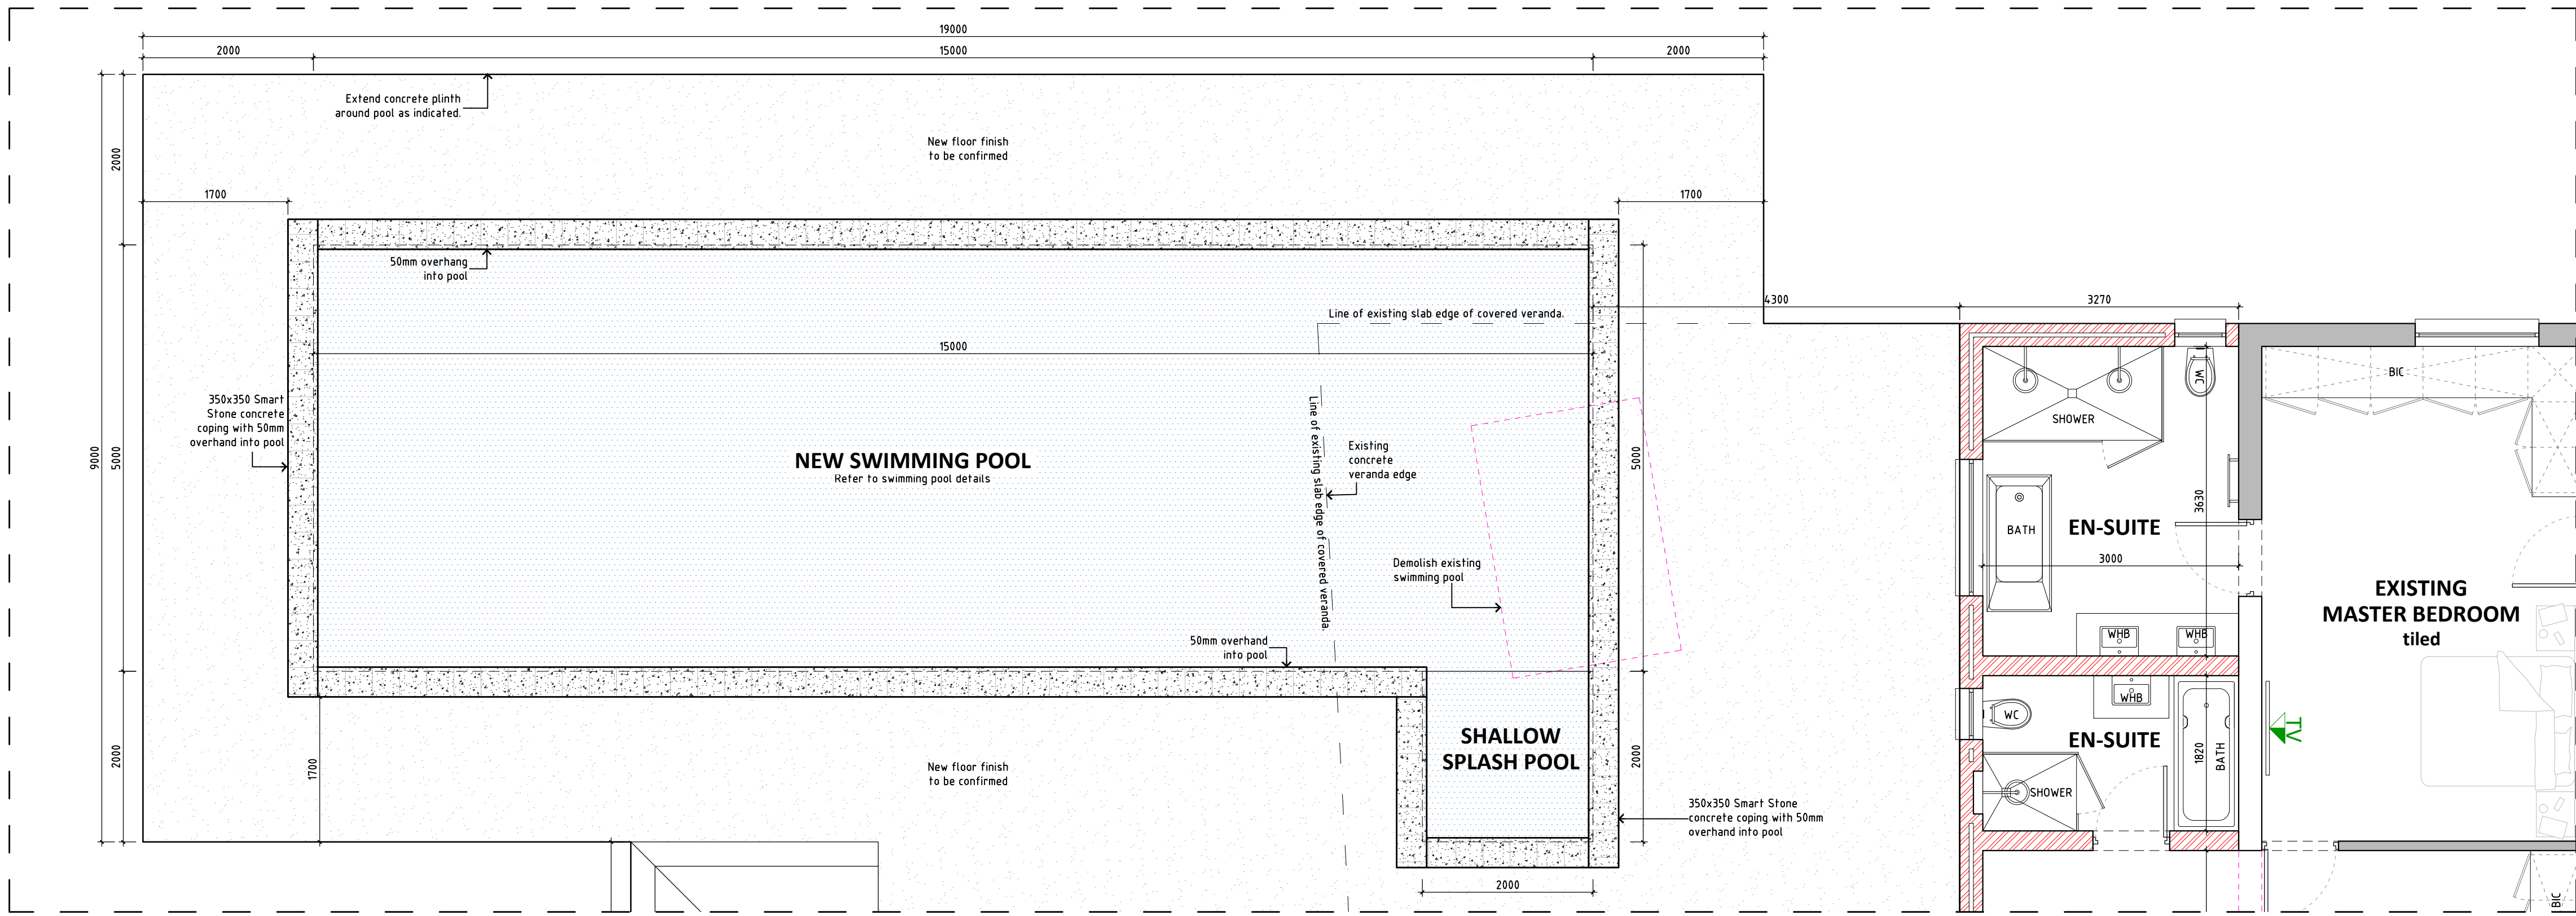


PART GROUND FLOOR PLAN
SCALE 1:50

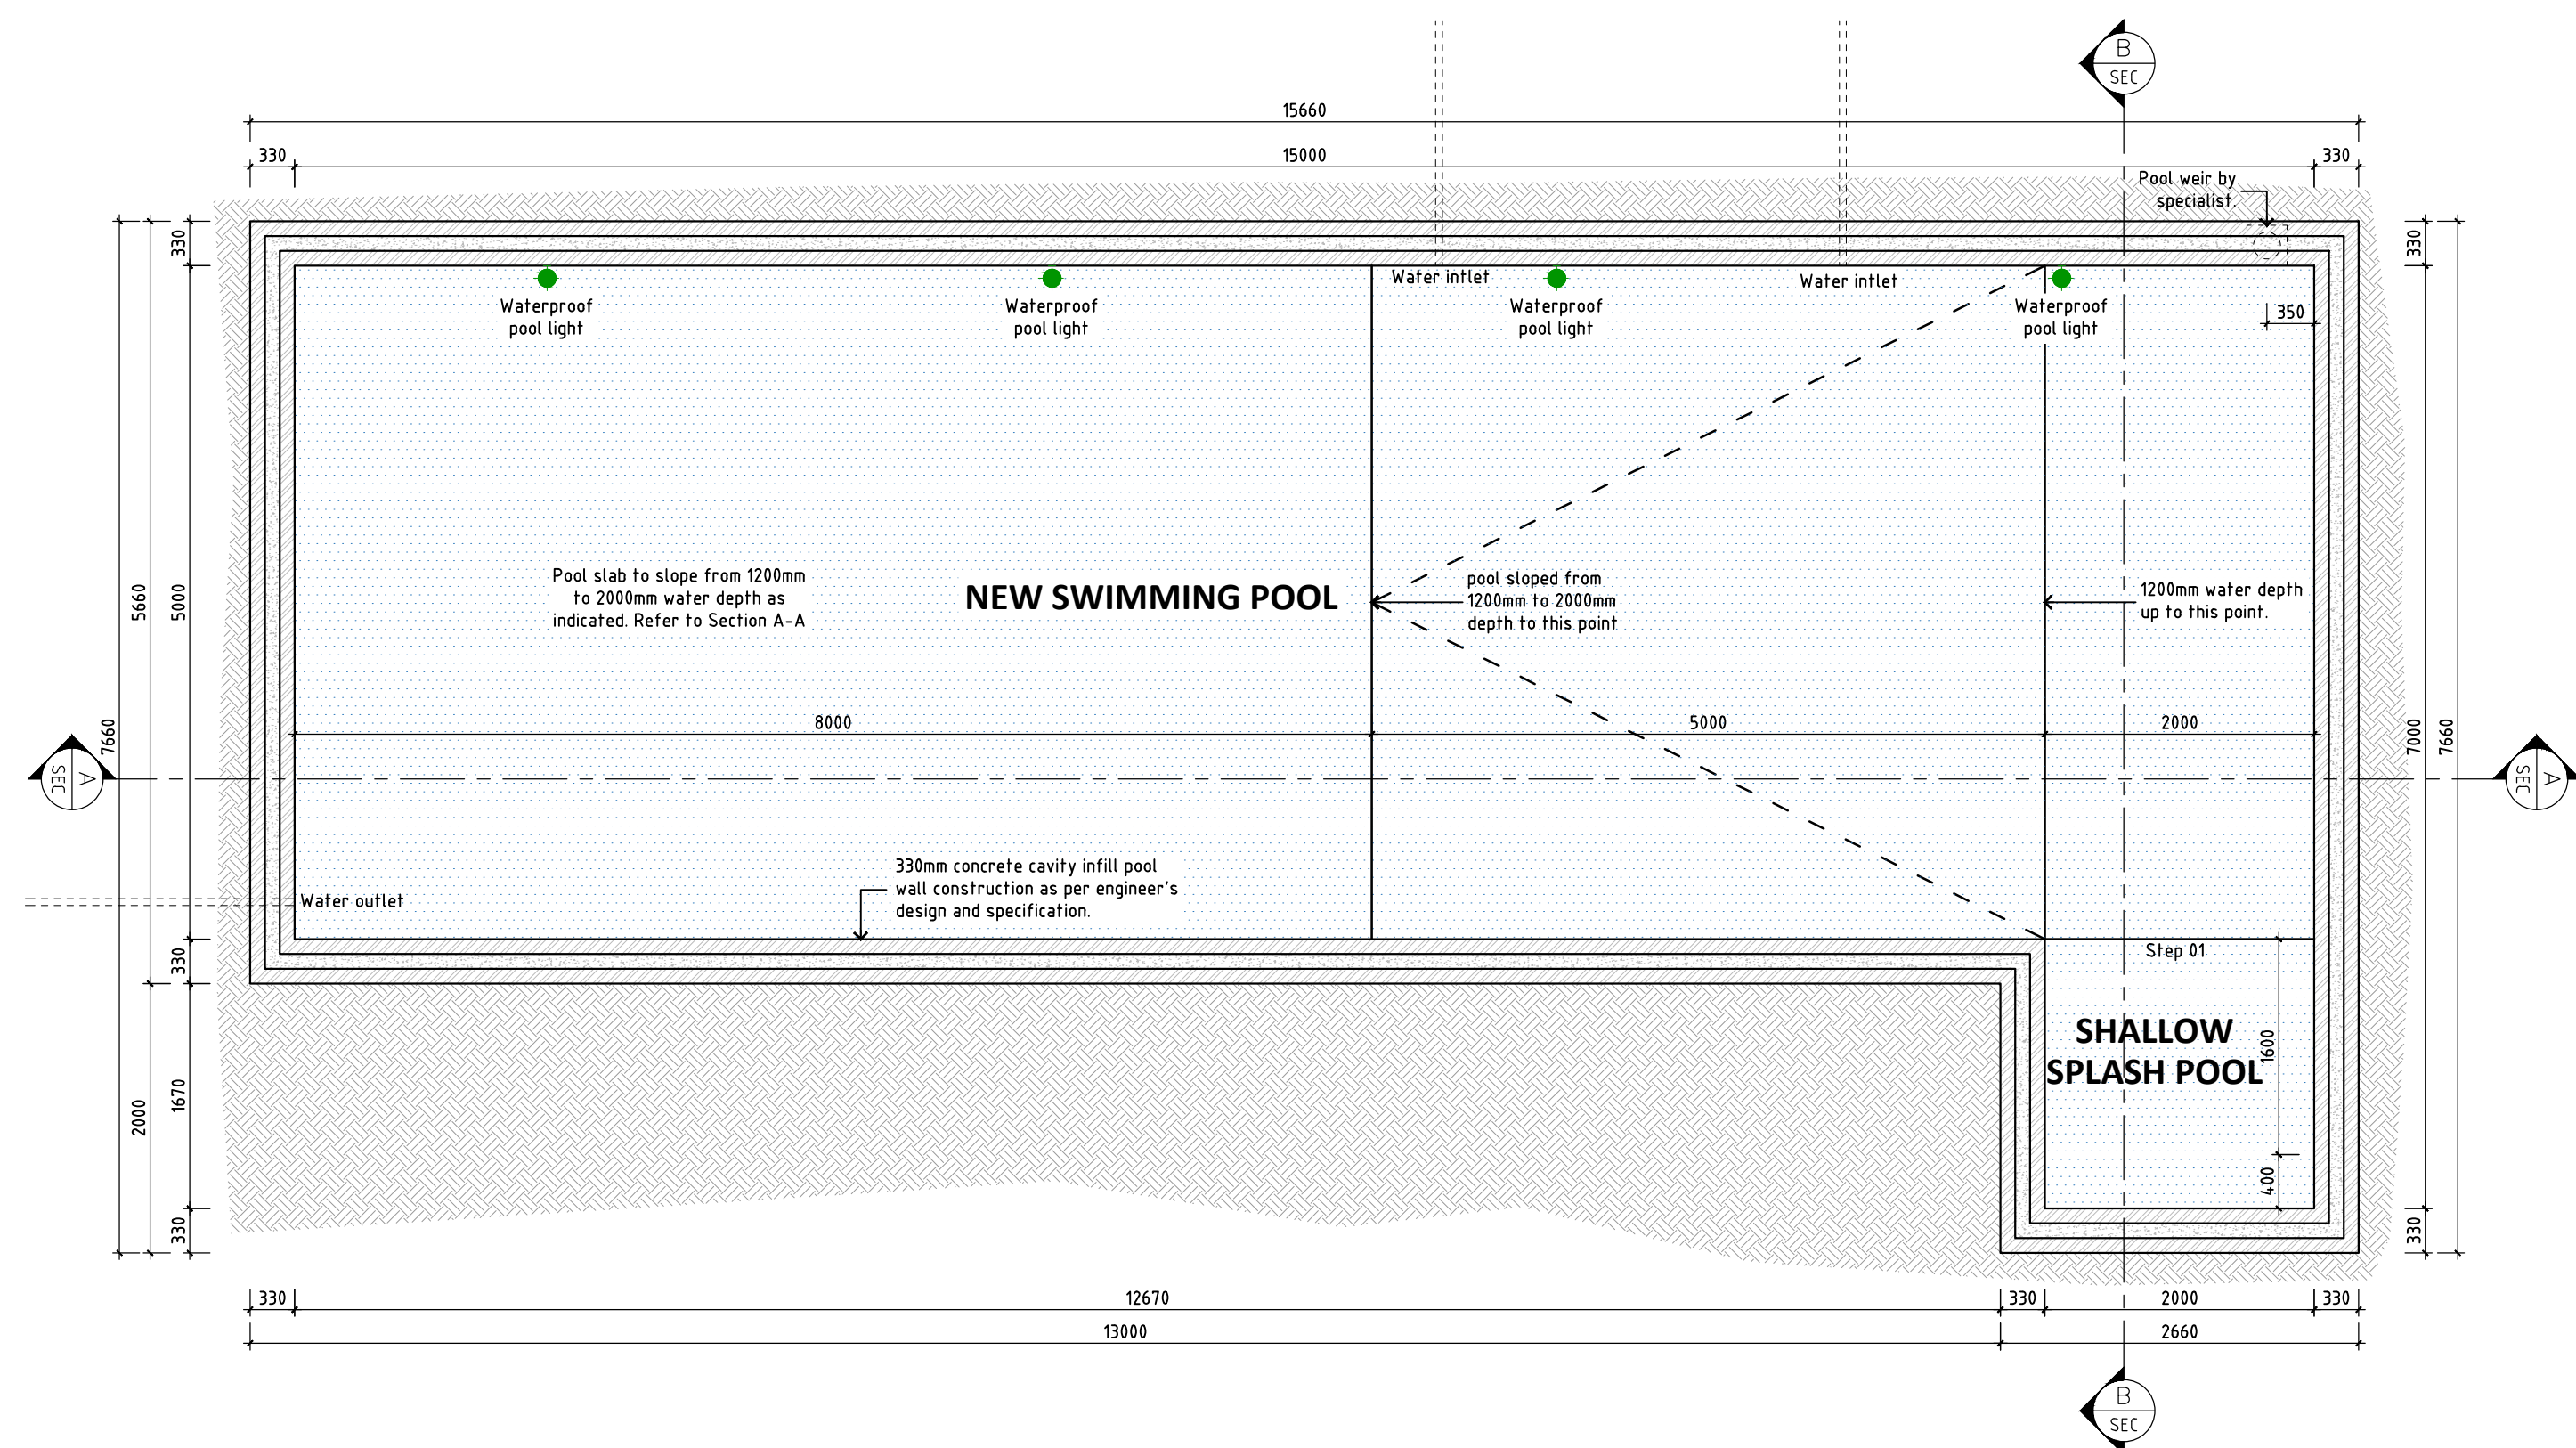

NEW SWIMMING PLAN
SCALE 1:50

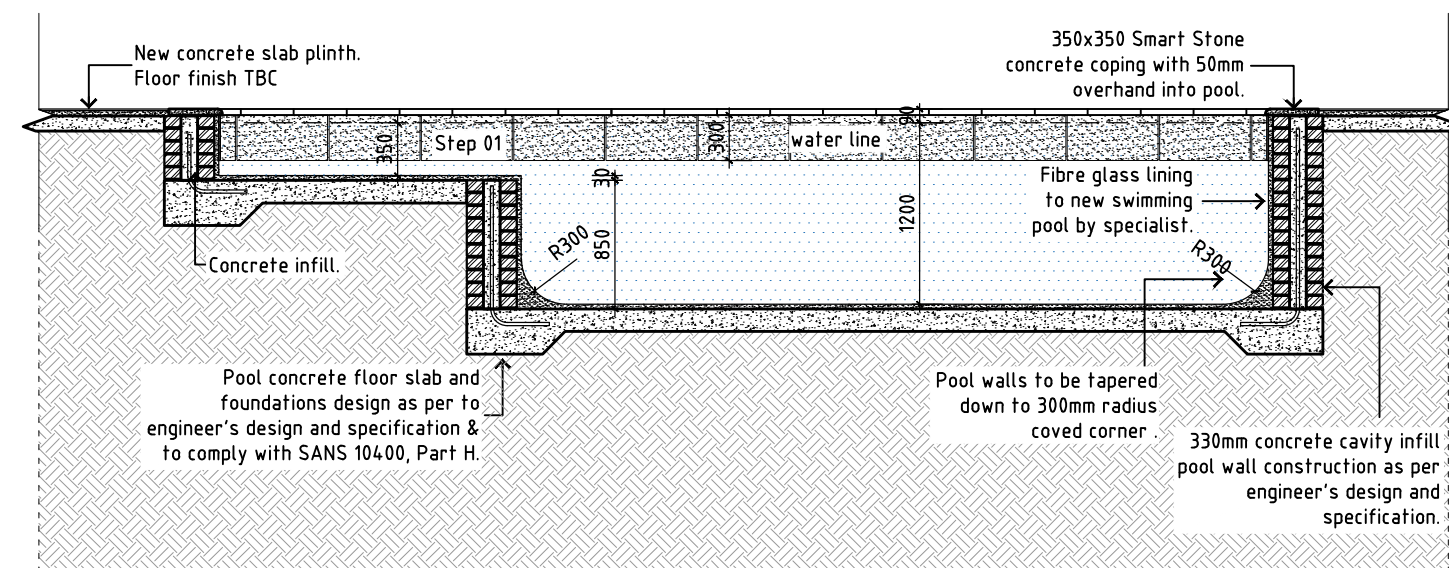

NEW SWIMMING SECTION B-B
SCALE 1:50

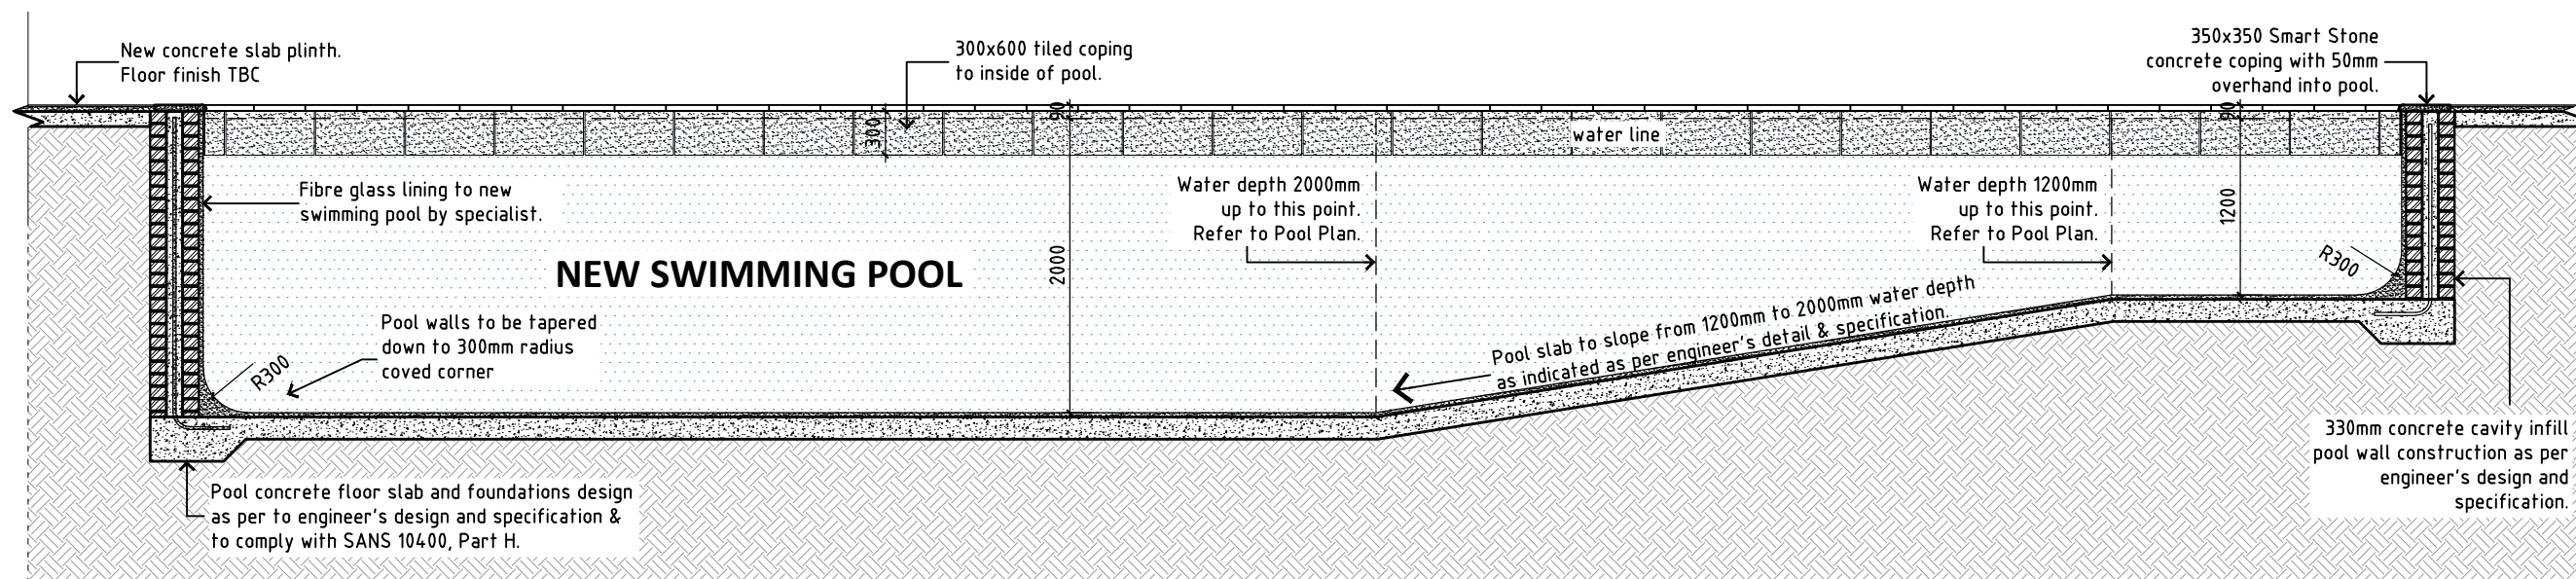

NEW SWIMMING SECTION A-A
SCALE 1:50

NOTES

ALL DIMENSIONS AND LEVELS ARE TO BE VERIFIED ON SITE BY THE CONTRACTOR BEFORE COMMENCING ANY WORK.
DIMENSIONS ARE NOT TO BE SCALED.
ALL VARIATIONS AND DISCREPENCIES ARE TO BE BROUGHT TO THE ATTENTION OF THE DESIGNER BEFORE COMMENCING ANY WORK.
COPYRIGHT OF THIS DRAWING, INCLUDING THE DESIGN AND DETAILS SHOWN HEREON IS RESERVED BY THE DESIGNER.

REVISIONS

REV.	DESCRIPTION	DATE
-	-	-/-/-
-	-	-/-/-
ISSUED FOR:

DATE

- ☐ PRELIMINARY
☐ APPROVAL
☐ TENDER
☒ CONSTRUCTION

AREA's

ERF		

South African Council for the
Architectural Profession Registration No.1353



Call: 084 504 2438 Email: bob@ellisarch.co.za
13 Irvine Street Richmond Hill Port Elizabeth 6001

PROJECT:

AS BUILT GROUND STOREY & NEW SWIMMING POOL

**MR. & MRS. VENTER,
8 ORANJESINGEL, KIRKWOOD**

DRAWING:

**SWIMMING POOL PLAN
SWIMMING POOL SECTIONS**

PROJECT NO:
V2020

SCALE:
as shown

DRAWN BY:
KL

CHECKED:
.....

DATE:
28/01/2021

REVISION:
A

DRAWING NO:
V2020.04