



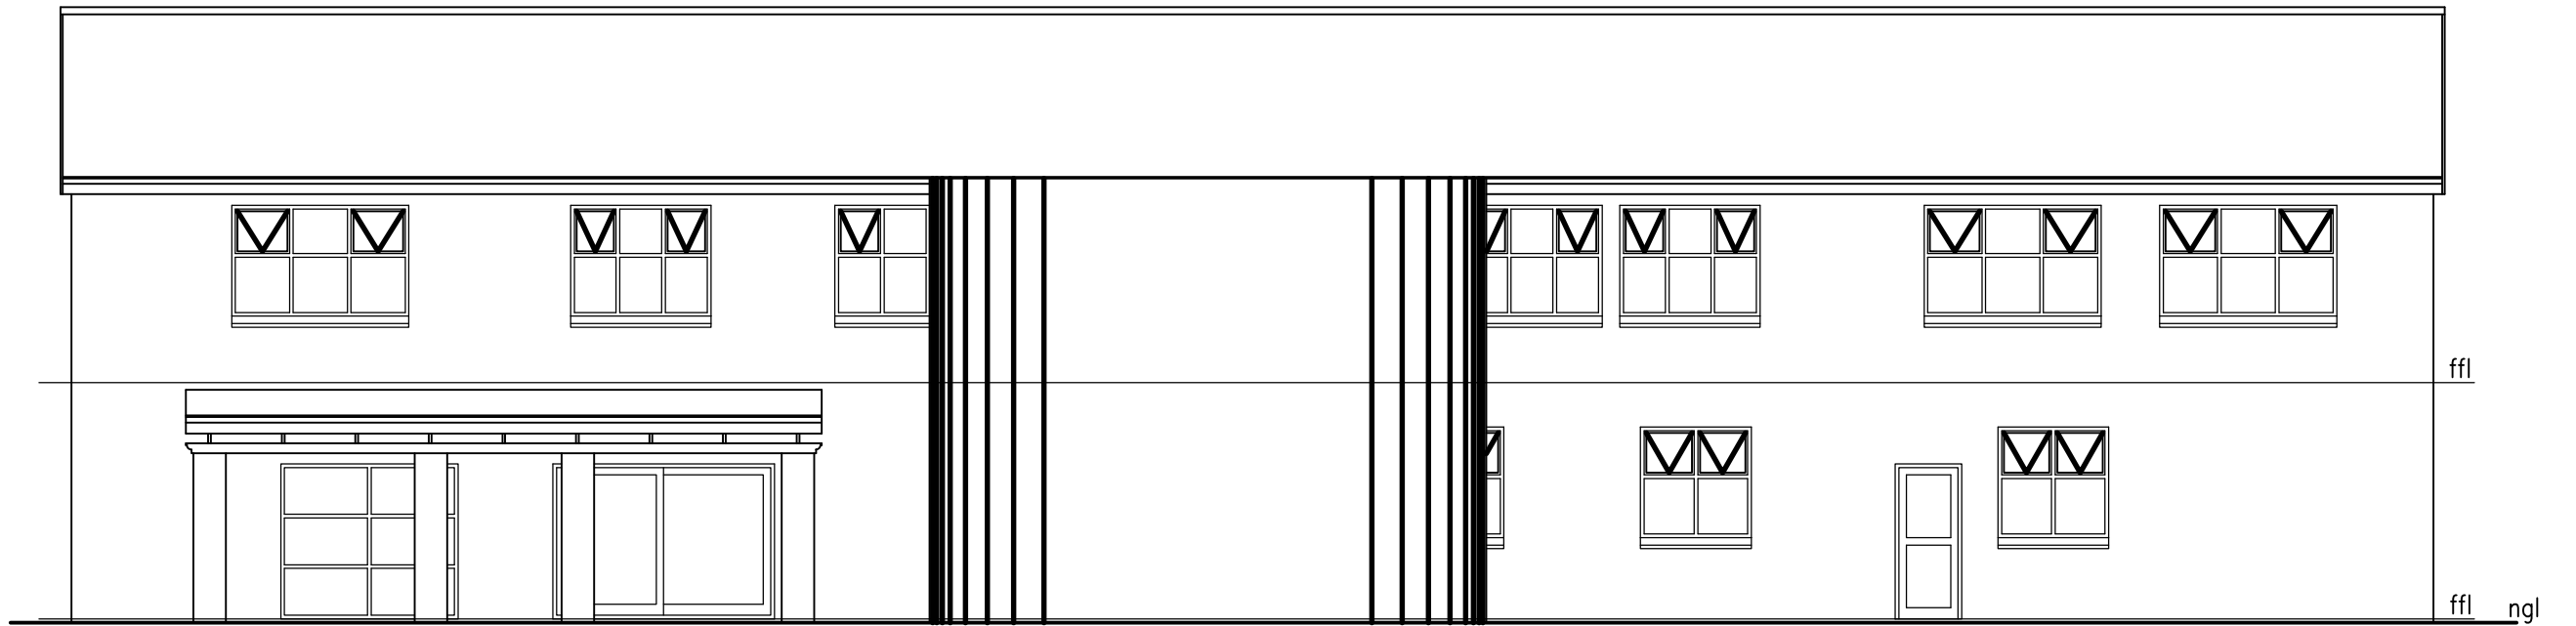

• ELEVATION

scale 1:100

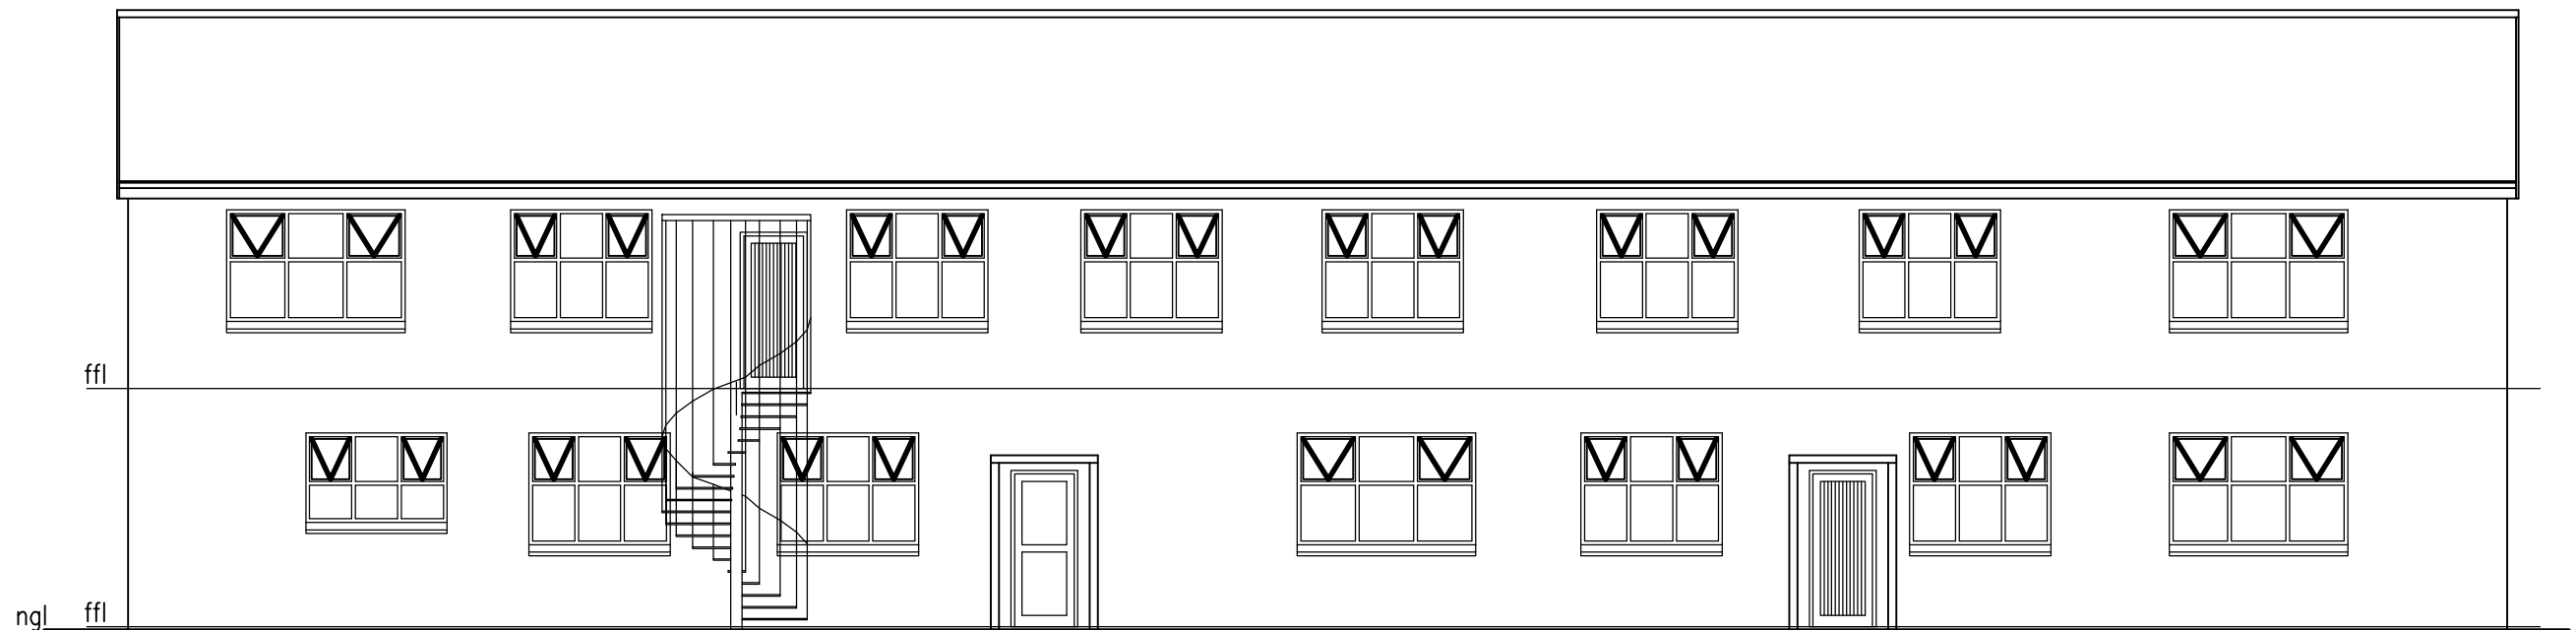

• ELEVATION

scale 1:100