


20260204 - HouseCopp_SK01

Copp

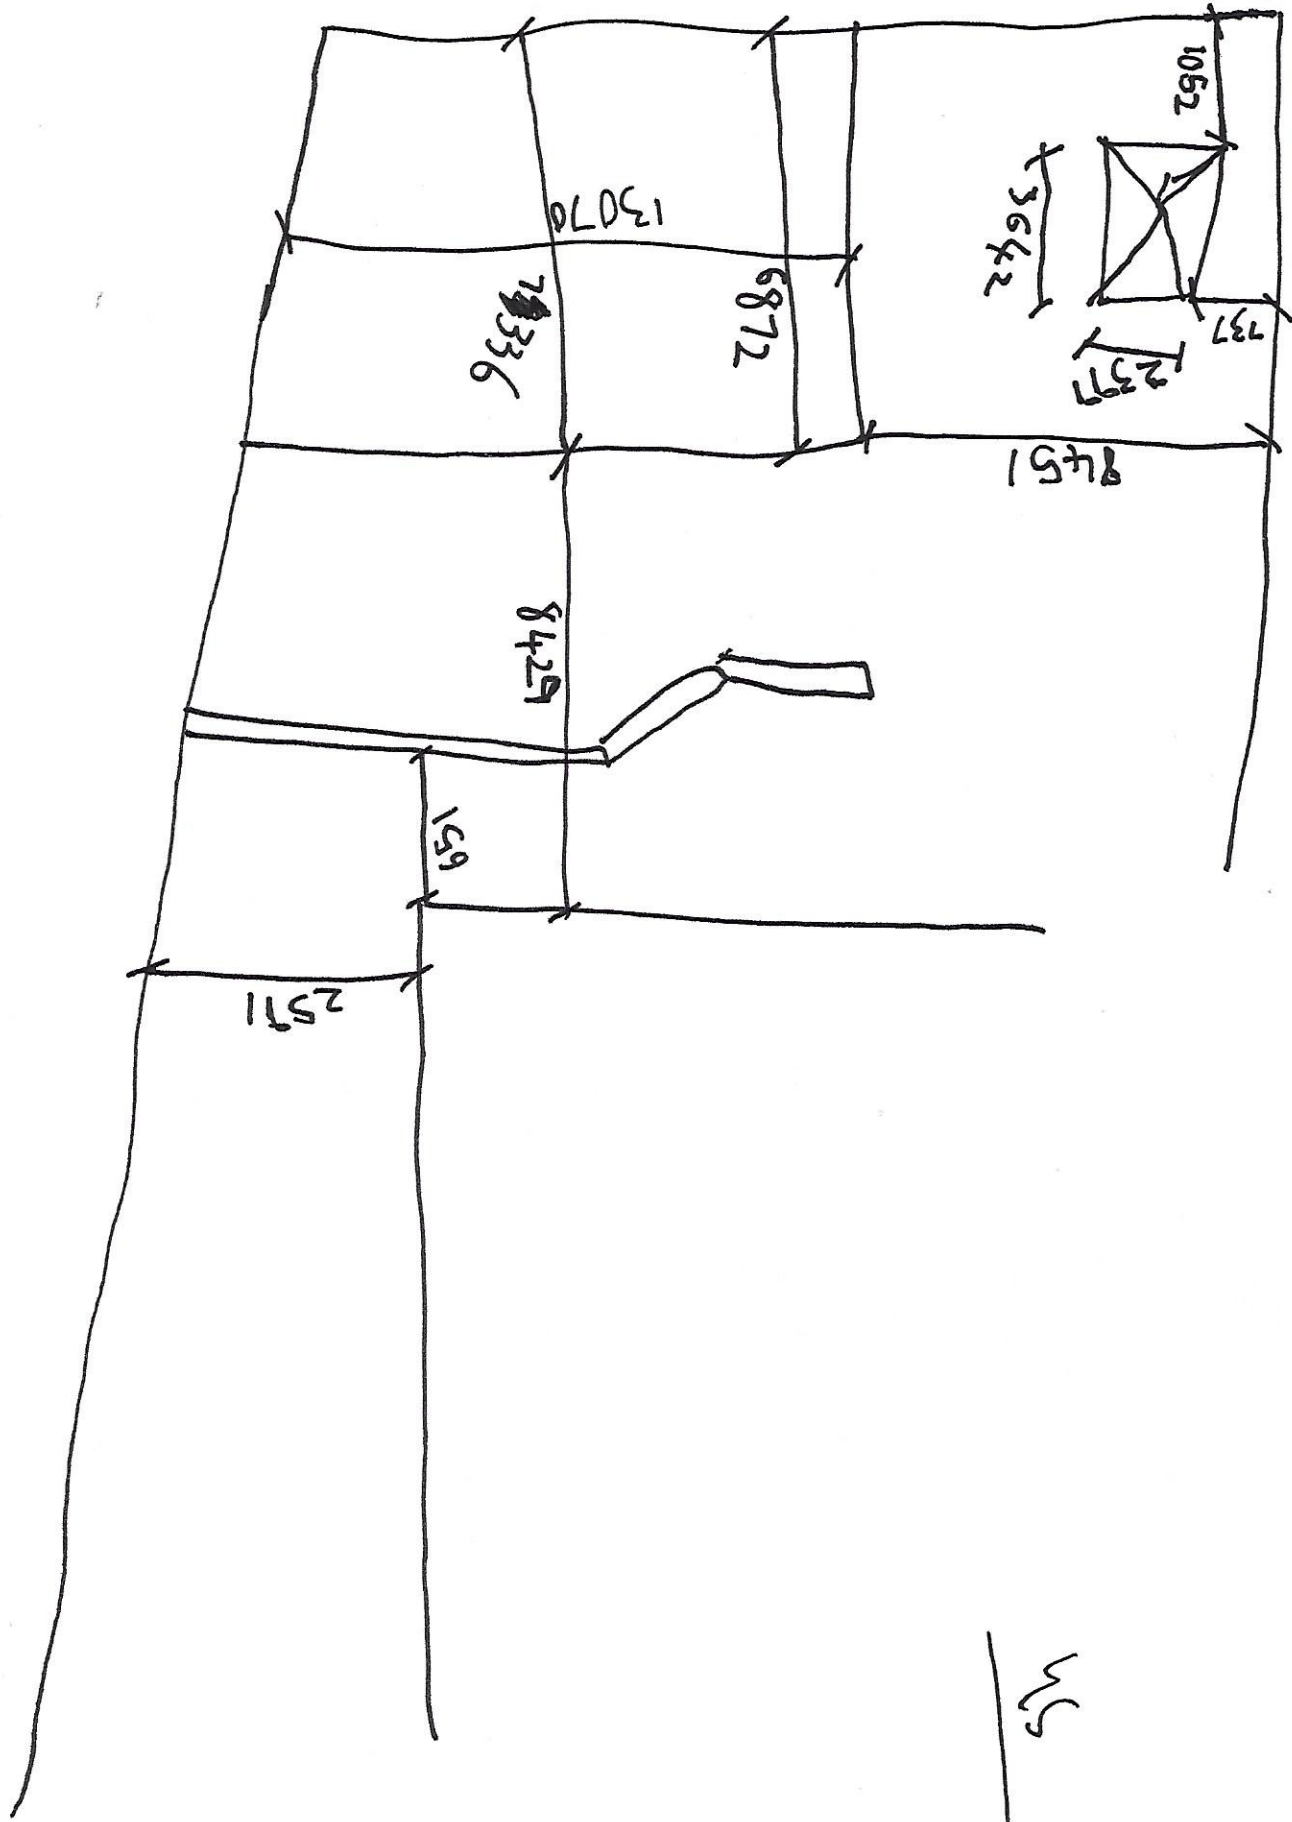

NS
N
T