



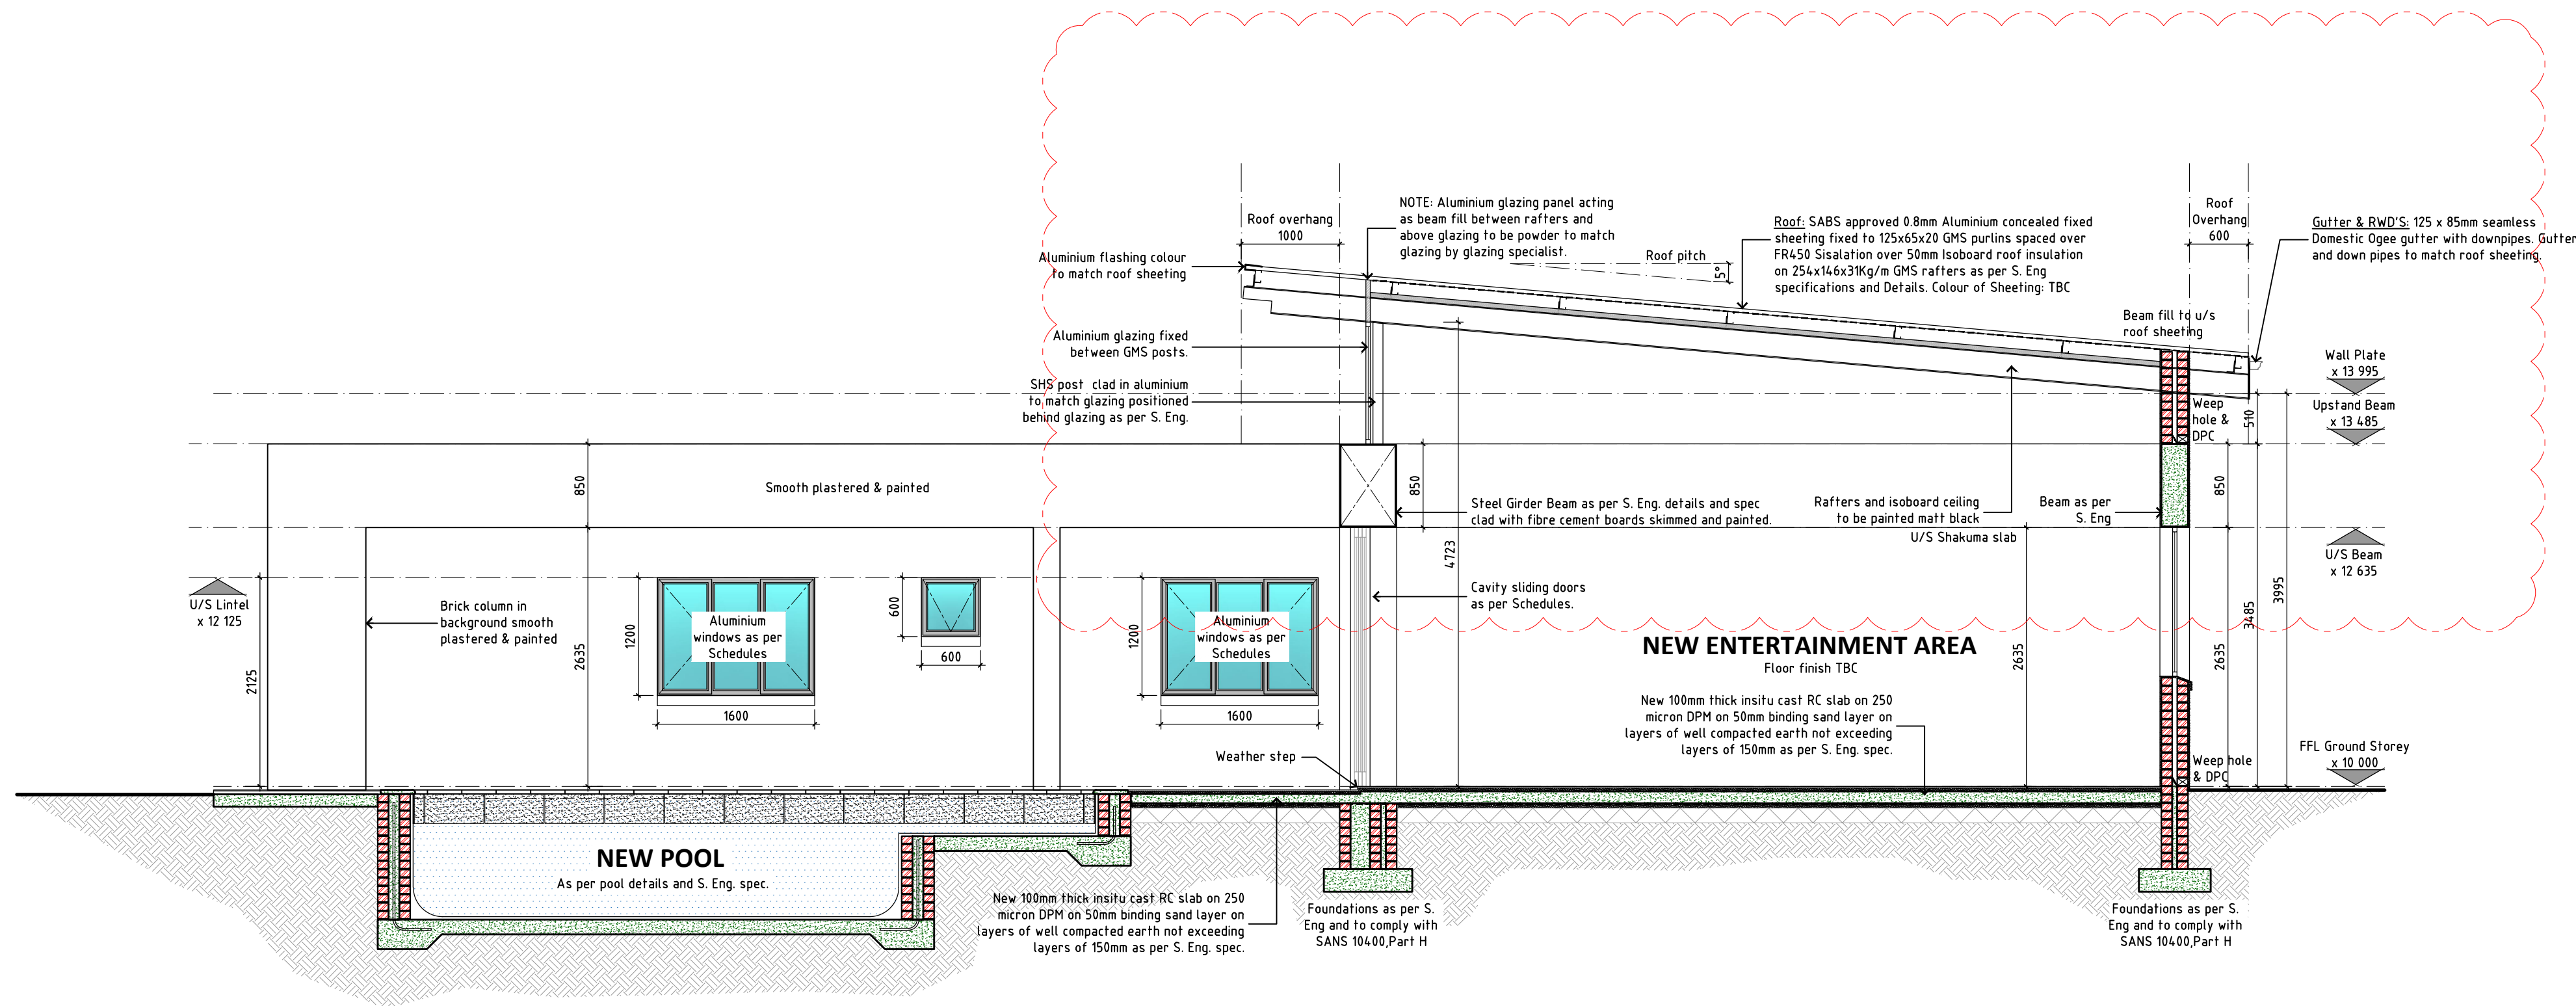

SECTION B-B
SCALE 1:50

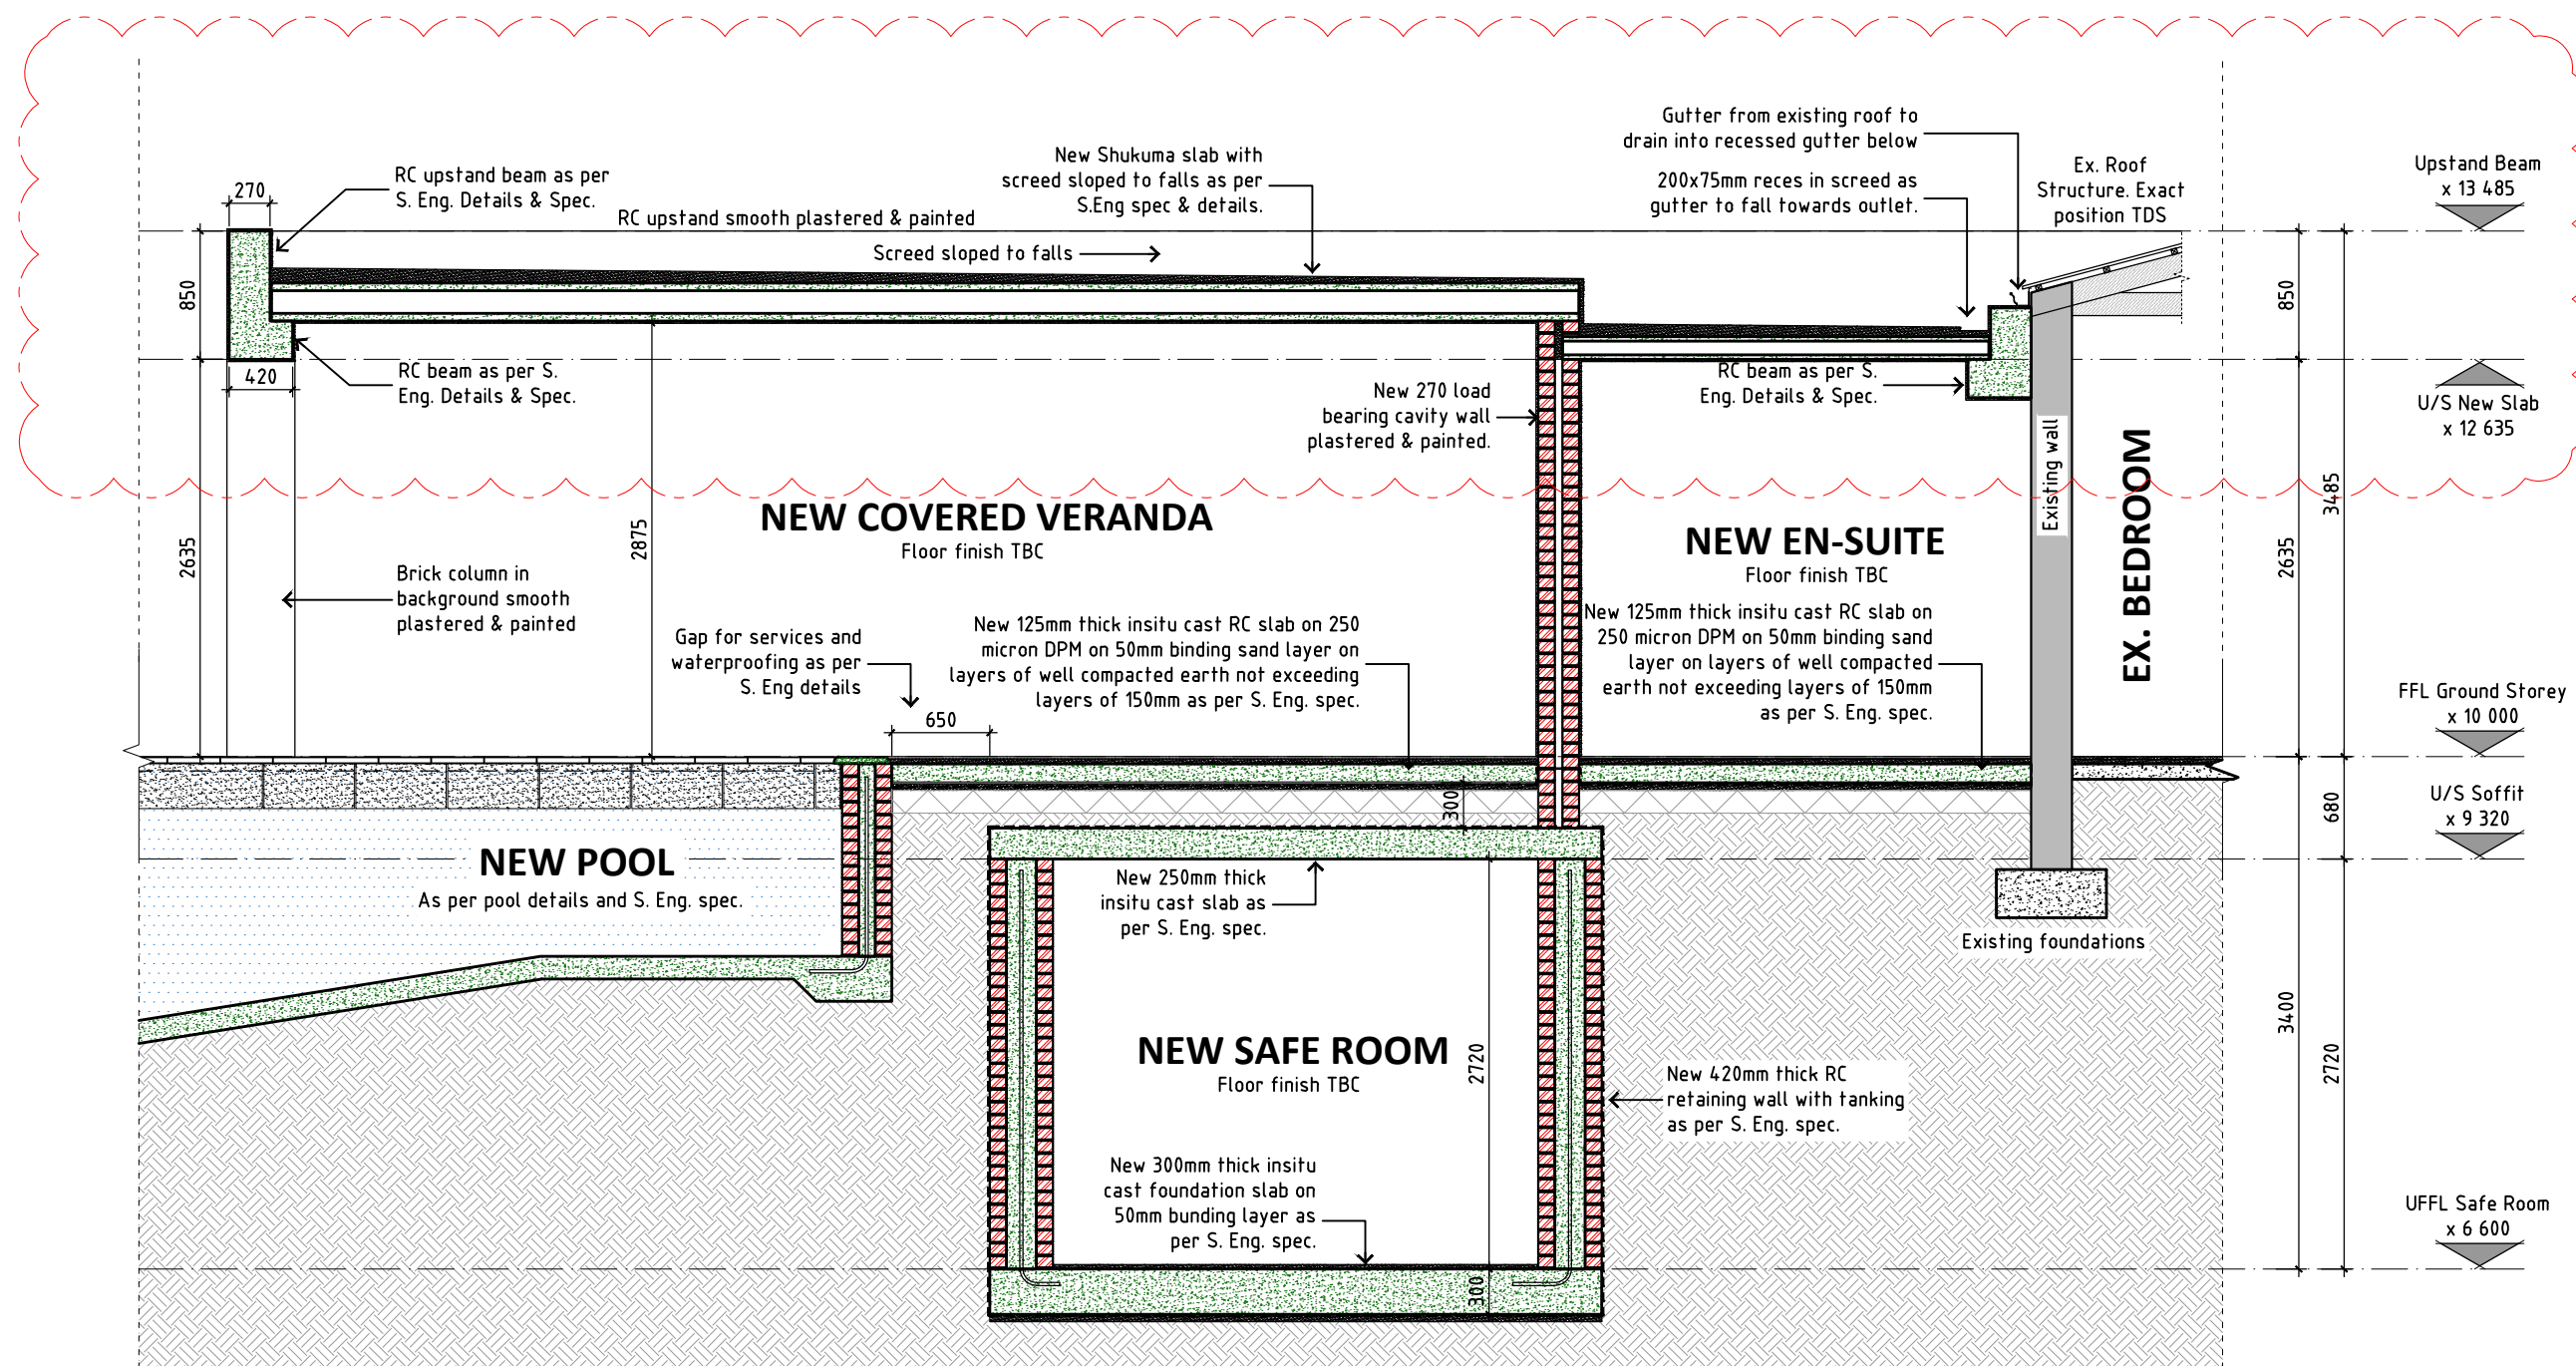

SECTION A-A
SCALE 1:50

NOTES

ALL DIMENSIONS AND LEVELS ARE TO BE VERIFIED ON SITE BY THE CONTRACTOR BEFORE COMMENCING ANY WORK.
DIMENSIONS ARE NOT TO BE SCALED.
ALL VARIATIONS AND DISCREPENCIES ARE TO BE BROUGHT TO THE ATTENTION OF THE DESIGNER BEFORE COMMENCING ANY WORK.
COPYRIGHT OF THIS DRAWING, INCLUDING THE DESIGN AND DETAILS SHOWN HEREON IS RESERVED BY THE DESIGNER.

REVISIONS

REV.	DESCRIPTION	DATE
1	Revised as indicated	15/2/2021
2	Revised Entertainment area width	16/2/2021
3	Revised as indicated	26/2/2021
4	Revised as per new on site measurements	4/3/2021
5	Revised slab/beam height for higher doors	3/5/2021
-	-	-/-/-
-	-	-/-/-
ISSUED FOR:

DATE

☐ PRELIMINARY

☐ APPROVAL

☐ TENDER

☒ CONSTRUCTION

AREA'S

ERF		

South African Council for the
Architectural Profession Registration No.1353



Call: 084 504 2438 Email: bob@ellisarch.co.za
13 Irvine Street Richmond Hill Port Elizabeth 6001

PROJECT:

ROOF PLAN

MR. & MRS. VENTER,
8 ORANJESINGEL, KIRKWOOD

DRAWING:

ROOF PLAN

PROJECT NO:
V2020

SCALE:
as shown

DRAWN BY:
KL

CHECKED:
BE

DATE:
03/05/2021

REVISION:
5

DRAWING NO:
V2020.07