


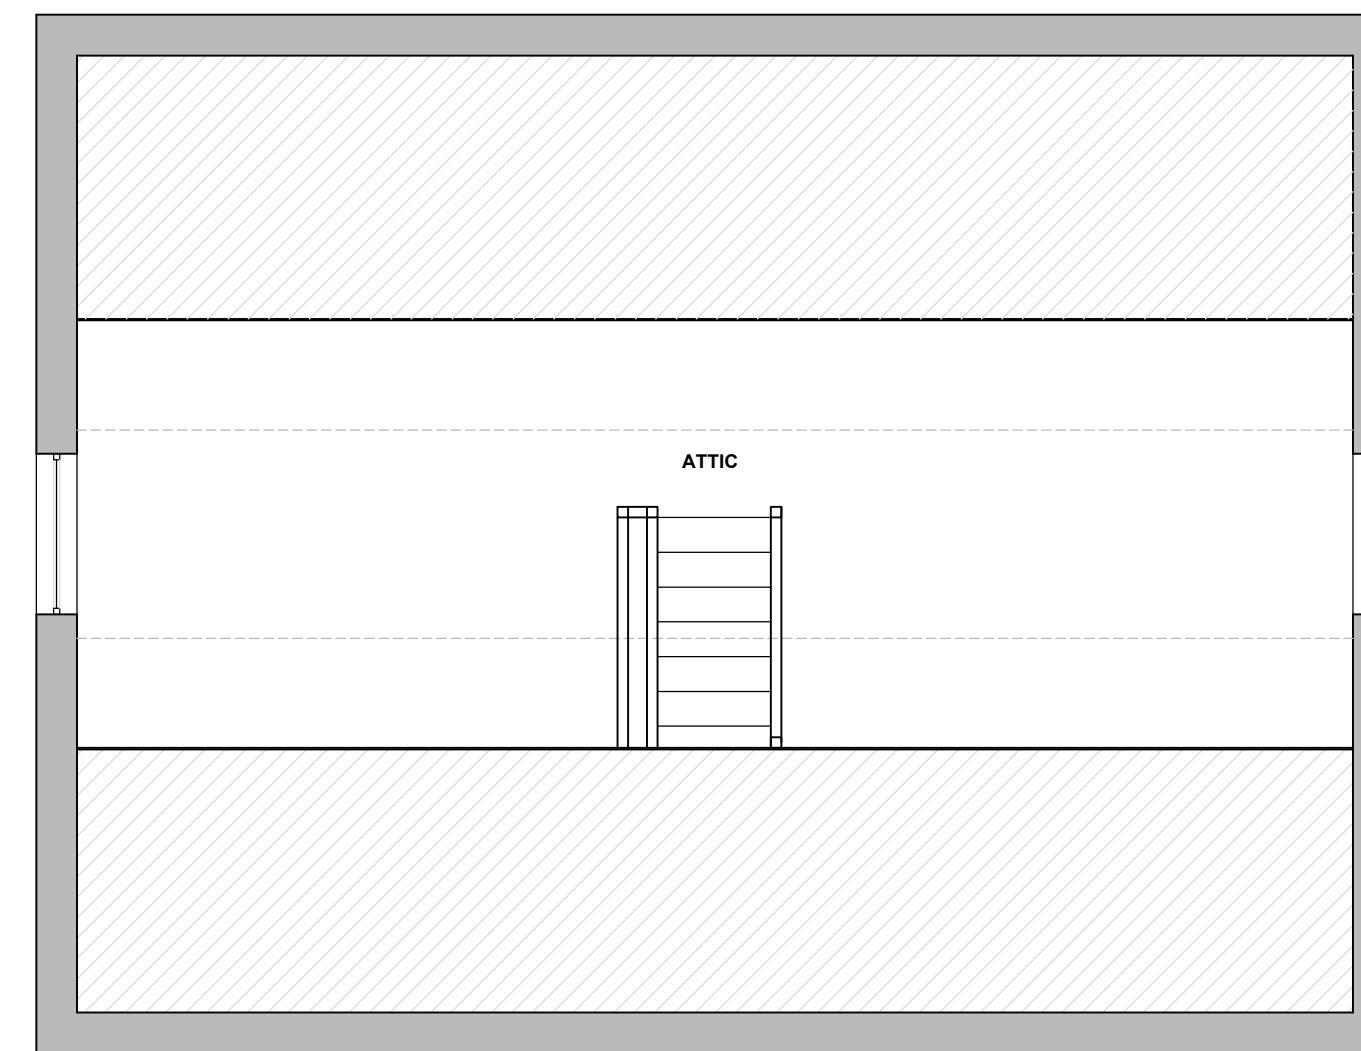

ATTIC FLOOR PLAN

SCALE 1:50

GENERAL NOTES:

[illegible]

DRAWING TITLE:

AS BUILT

PROJECT TITLE:

AS-BUILT DRAWINGS ON **ERF 166,**
LORRAINE , PORT ELIZABETH FOR Mr &
Mrs Van Dyk

May 25

CLIENT SIGNATURE



<https://blackhoundenterprises.com>

<https://blackhoundenterprises.com>

Fairview, Port Elizabeth, 6070

8 May 25

PROFESSIONAL SIGNATURE

MUNICIPAL INFORMATION:

ERF NO:	166, Lorraine
ERF AREA:	455 sqm
EXISTING AREA:	92.5 sqm
NEW AREA:	0 sqm
TOTAL AREA:	93 sqm
EX. COVERAGE:	133.52 sqm - 29%
NEW COVERAGE:	0 sqm - 0%
TOTAL COVERAGE:	134 sqm - 29%
NEW GARAGES:	0
NEW BATHROOMS:	0
POOL:	NO
BOUNDARY WALLS:	0 M
AGE OF BUILDING:	EXISTING



COPYRIGHT:

This drawing is subject to copyright, and may not be reproduced in whole or part in any matter whatsoever without written permission from Blackboud Architecture & Rendering.

PROJECT NO.:

2024DYK

DRAWING NO.:

2024_VANDYK_

DRAWN BY:

PRINT DATE:

REVISION NO.:

00

00

SHEET NO.:

101

101