



All on site dimensions should need to be taken on site prior to manufacturing and installation

[illegible]

**PROPOSED SUB-STATION
(Z3-SS-009) ON ERF 228, COEGA,
PORT ELIZABETH FOR COEGA
DEVELOPMENT CORPORATION**

CLIENT SIGNATURE
FOR COEGA DEVELOPMENT CORPORATION


AS-BUILT DRAWINGS

ARCHITECT SIGNATURE
Reg no. PrArch 21014

TEL: 041 581 1590 Unit 6
CELL: 083 295 3601 1 Bridge Street
FAX: 086 547 5423 South End
6001
email: dal@dmvarchitecture.co.za

MUNICIPAL INFORMATION:

ERF NO:	228, COEGA
ERF AREA	7269 sqm
EXISTING AREA:	0 sqm
NEW AREA:	77 sqm
TOTAL AREA:	77 sqm
EX. COVERAGE	0 sqm 0.0%
NEW COVERAGE	77 sqm - 1.
TOTAL COVERAGE	77 sqm - 1.1
NEW GARAGES	0
NEW BATHROOMS:	0
AGE OF BUILDING	NEW

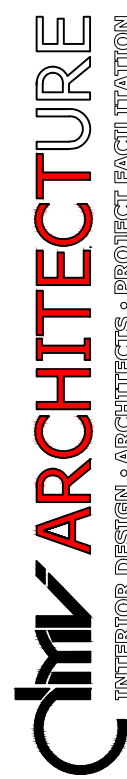

COPYRIGHT

This drawing is subject to copyright, and may not be reproduced in whole or part in any matter whatsoever without written permission from DMV Architecture.

PRINT DATE:
5 September 2017

DRAWN BY:
DMP

CHECKED BY:
DMV / NF

PROJECT NO.
10254-00_A_SUB_A_103_REV0_ZONE3SUB009

REVISION NO.	0
--------------	---

SHEET SIZE

A1

SHEET NO.

106

