




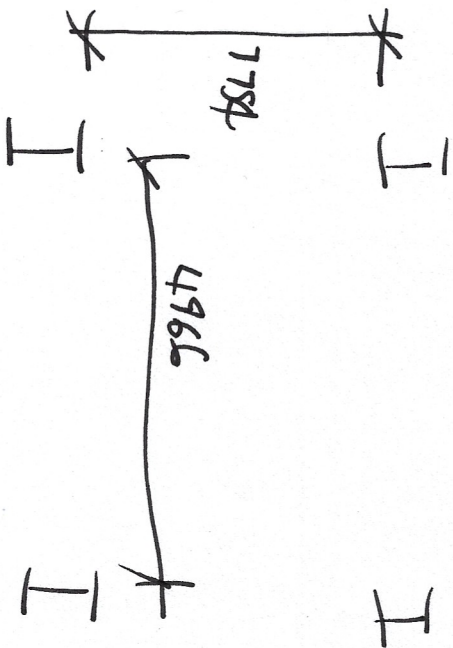

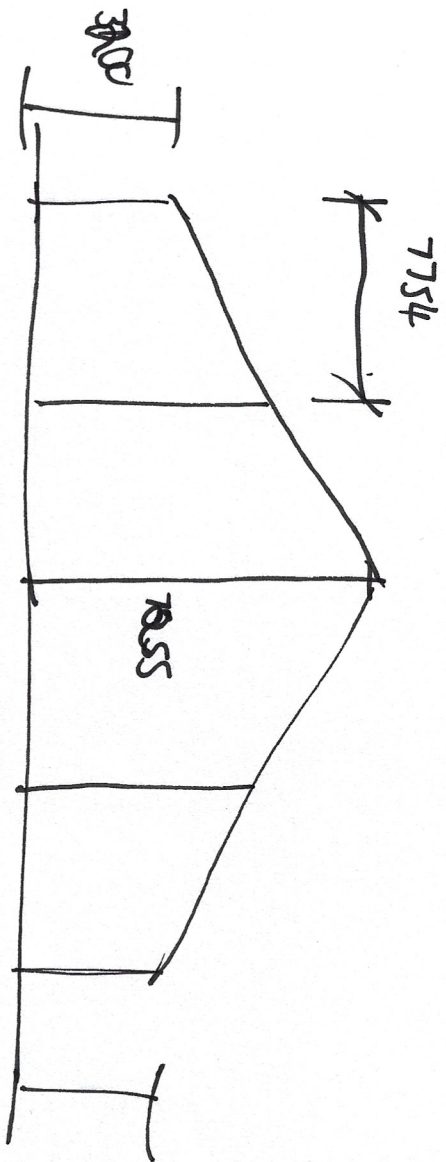

CA: 2765

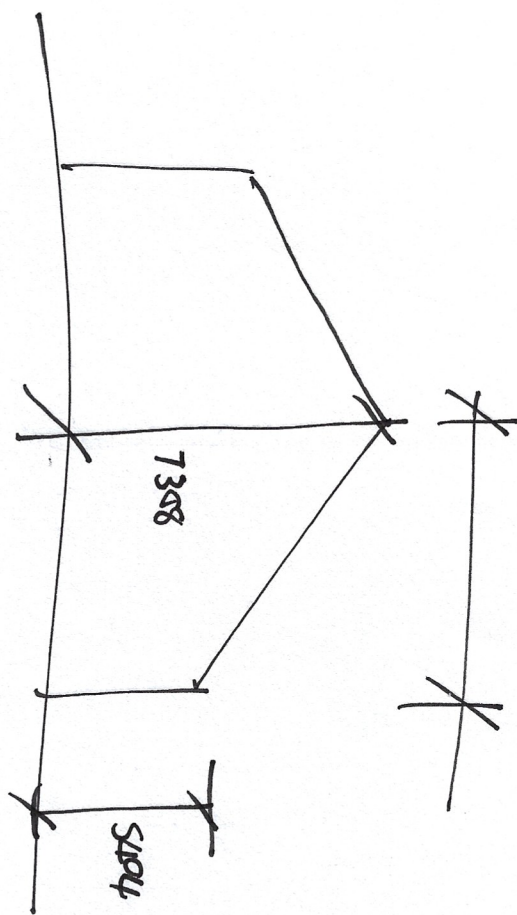