


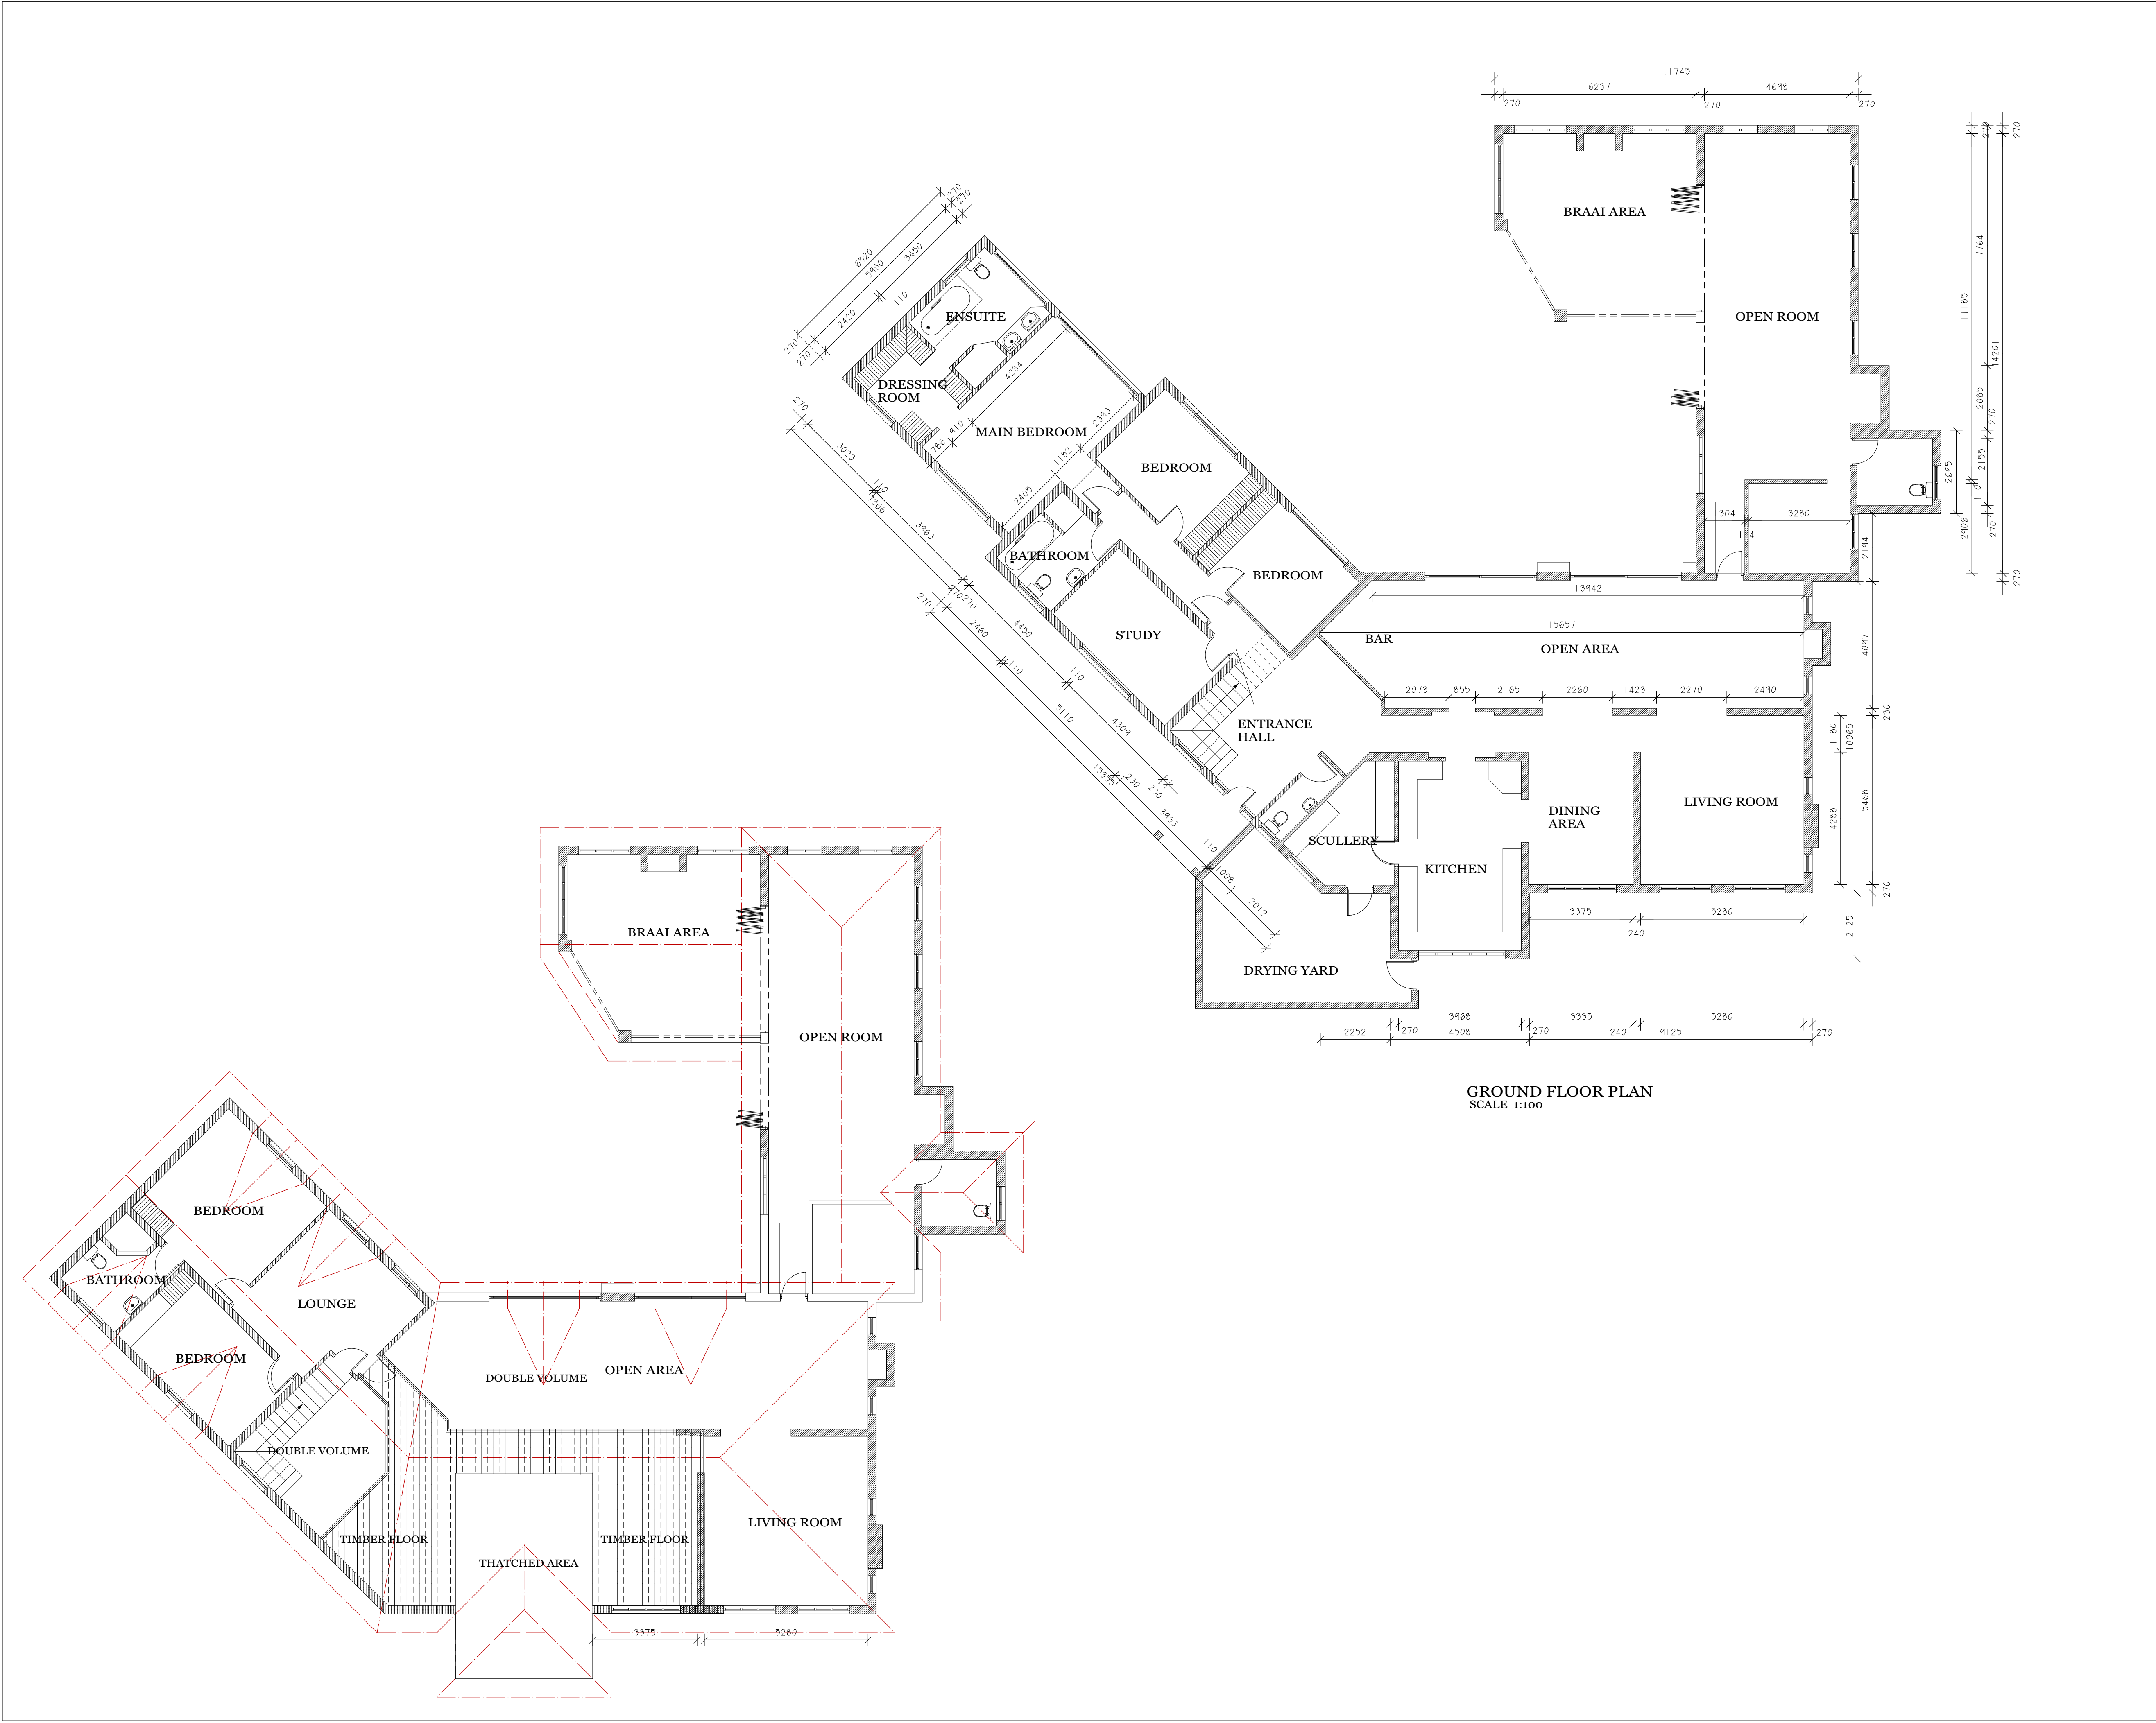


NOTES		
1. All dimensions and levels to be checked on site and where applicable to match existing structure.		
2. Any discrepancy or contradiction to immediately be reported to the Architect.		
3. Drawings not to be scaled.		
4. Use profile columns at 85mm. centres for brickwork except where specified differently.		
5. A complete set of drawings to be available on site at all times.		
6. All dimensions as shown- plan to be plotted on site at a horizontal level.		
7. The contractor is responsible for the correct layout of buildings on site in relation to site boundaries and building lines.		
8. All drawings to be read in conjunction with structural engineers detail and drawings.		
9. Finished structures to comply with latest amendment of sabs 0400		
10. All specialist work (plumbing/electrical/roof/concrete) ETC to be checked and verified prior to commencing with work		

REVISIONS		
Rev	Date	Description
GENERAL NOTES:		

AREA:	
AREA OF GROUND FLOOR:	400m ²
AREA OF FIRST FLOOR:	72m ²
TOTAL AREA:	472m ²

BRICKWORK LEGEND:	
	EXISTING BRICKWORK
	NEW BRICKWORK
	DEMOLISHED BRICKWORK

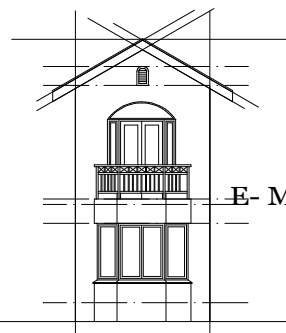

01 FROST STREET
QUEENSTOWN
5320

CELL: 083 445 7877
E- MAIL: demstones@awe.co.za

CDS ARCHITECTURAL SERVICES

CLIENT:
MR AND MRS HOGBEN SANDPEBBLES CHELSEA PORT ELIZABETH

PROJECT:
AS BUILT HOUSE PLANS

DRAWN:	C D STONE
DATE:	JANUARY 2020
SCALE:	AS SHOWN

DRAWING: AS BUILT PLANS		
PROJECT NO:	DRAWING NO:	REVISION:
CDS20005	100	R00