


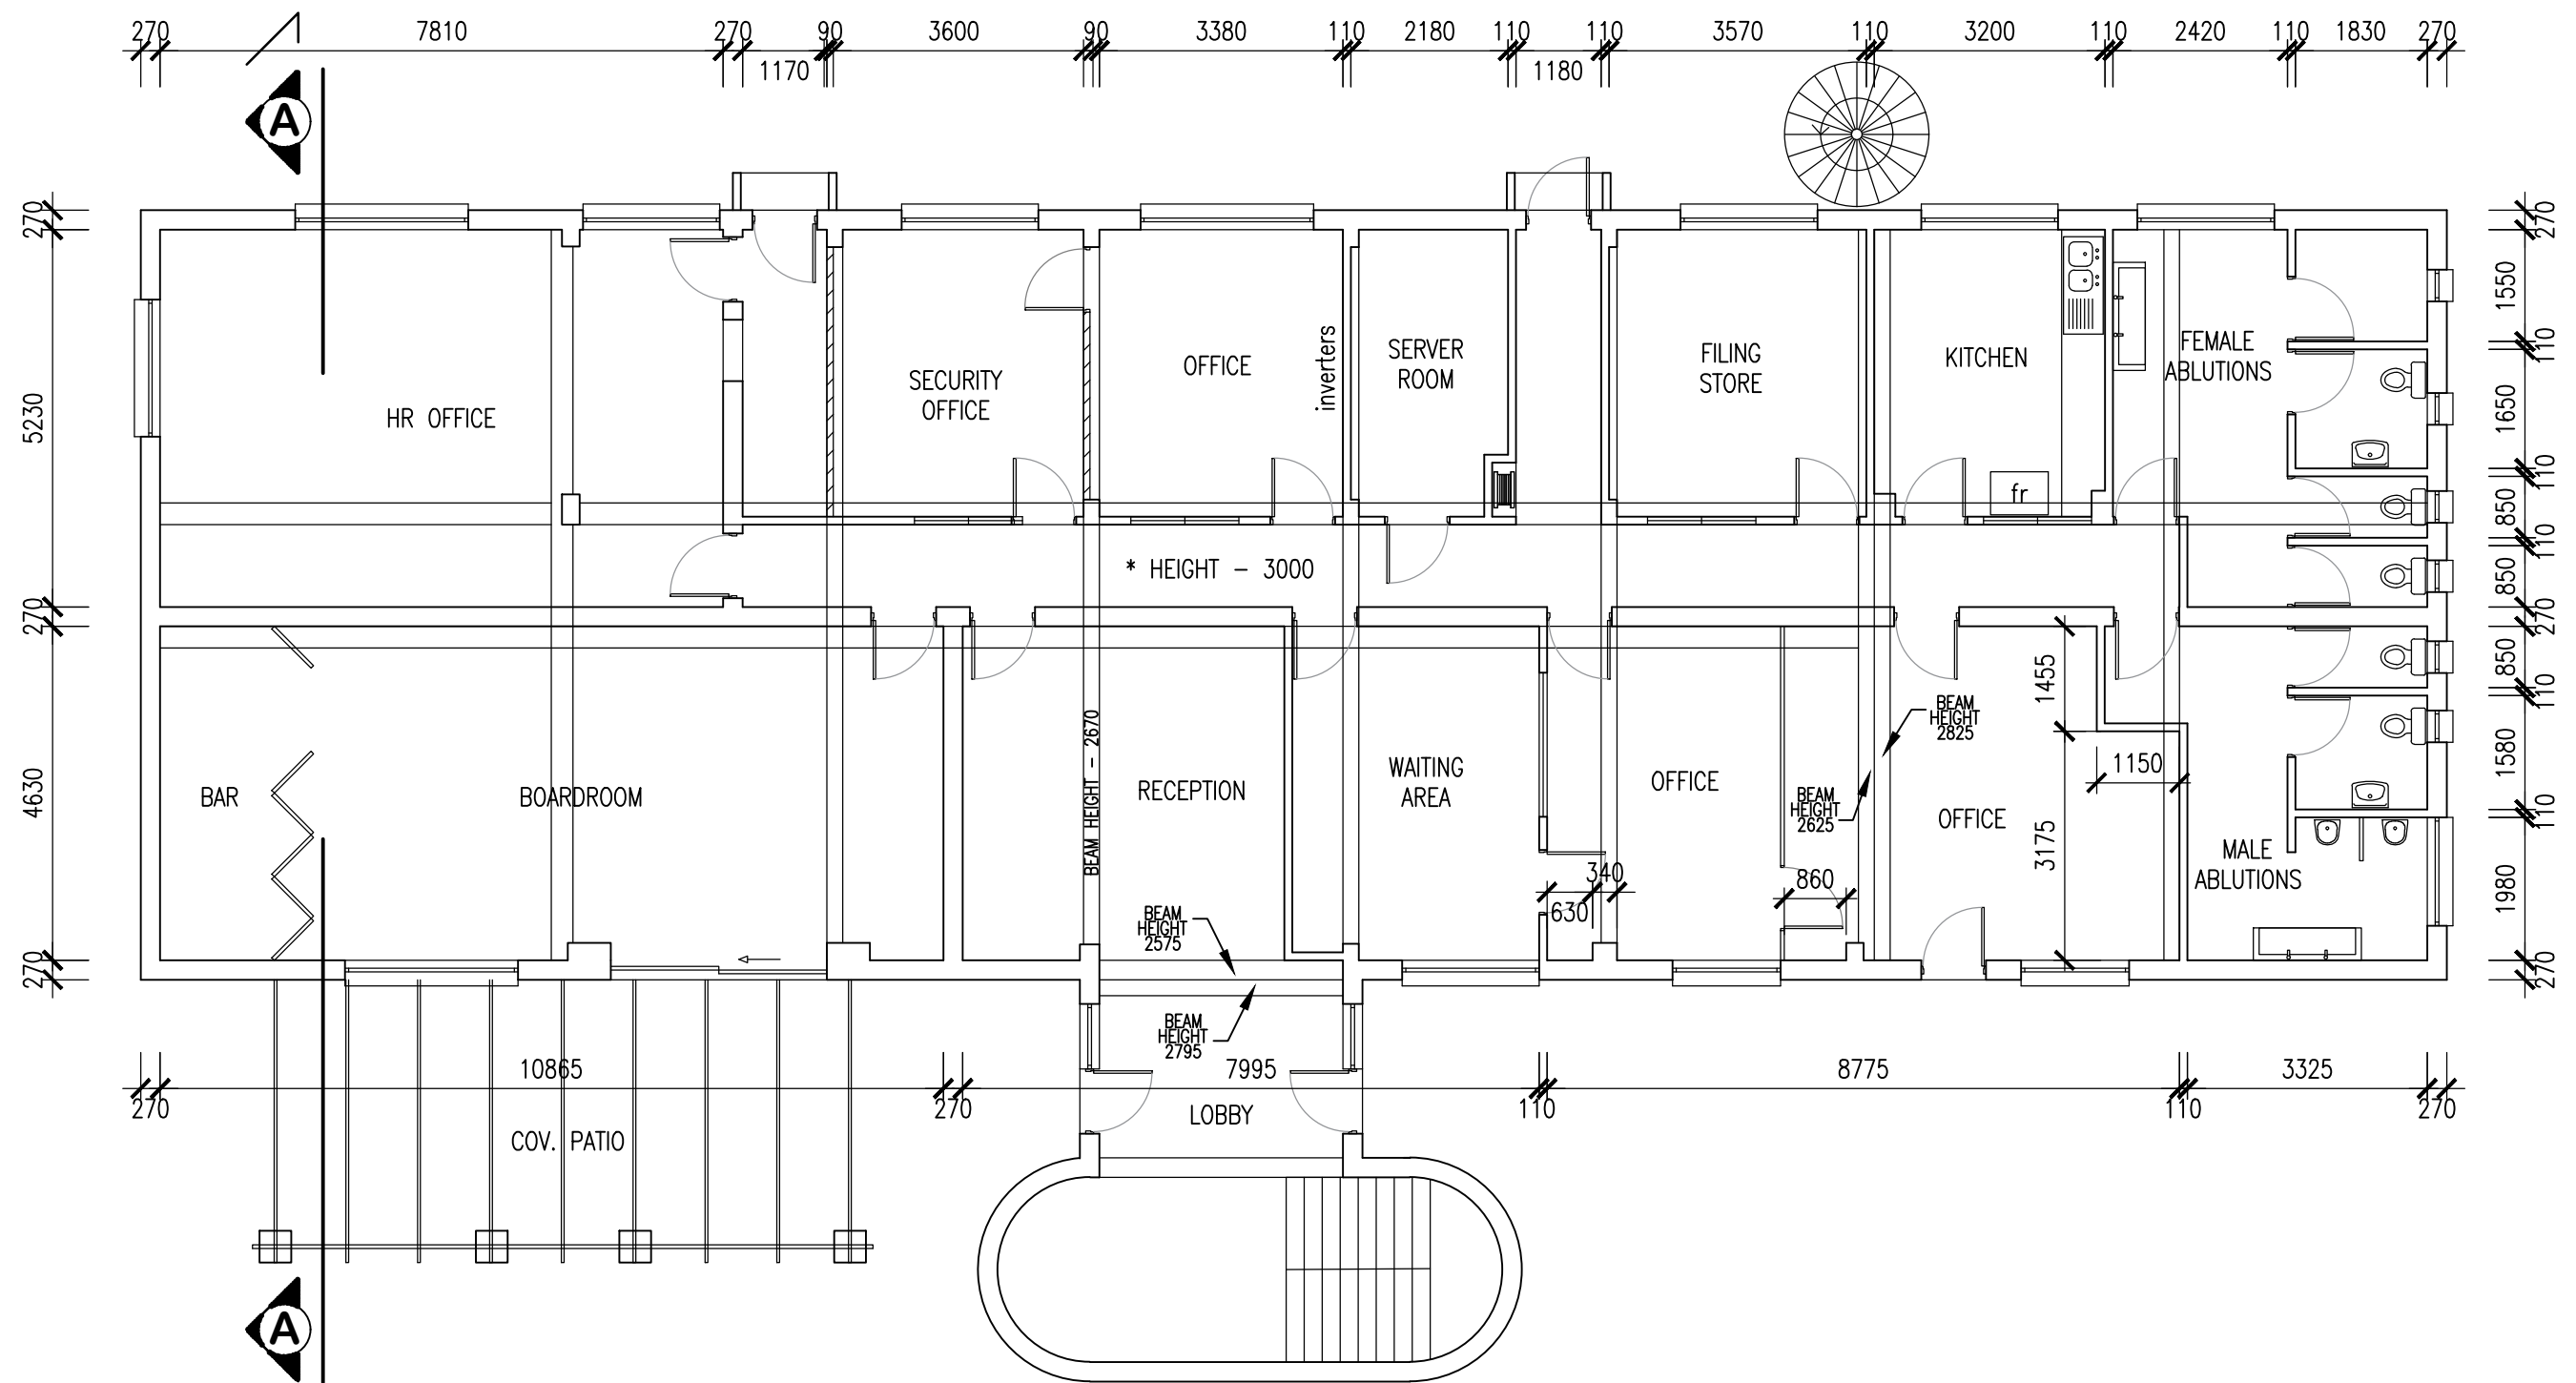

• **GROUND STOREY**
scale 1 : 1 0 0